

APR 08 1999

Ogemaw County Remonumentation
LAND CORNER RECORDATION CERTIFICATE
Filing Requirement of Act 74, Mich. P.A. 1970

SECTION

LIDER 3 PAGE 207

STATE OF MICHIGAN
OGEMAW COUNTY
RECORDED

23 DEC 1998 3:47:32 P

WANDA MUZIK
REGISTER OF DEEDS

Register of Deeds Stamp & File Number

For comers in

Table with columns: Ogemaw (County), Located in:, Corner Code #. Rows include Public Land Survey, Property Controlling in Section, and Miscellaneous Property in Sec.

4. Lot No. , Recorded Plat
5. Private Claims

I, Timothy L. Lapham, in a field survey on December, 19 98, do hereby state that under requirements of P.A. 74, Michigan P.A. of 1970, the corner points mention in lines 1 and 2 above were in conformance with regulations and rules therefore as required in the current manual of survey instructions of the United States Department of the Interior, Bureau of Land Management or by a decree of a Court of Law and/or that the corner points mentioned in lines 3, 4 and 5 above were in conformance with the rules of the Michigan Board of Land Surveyors or by a Decree of a Court of Law; established, re-established, monumented, recovered, found as expressed below:

NOTE: Not more than 2 corners, all in the same town and range, may be recorded on this certificate

Grid table with columns A-L and rows 1-13. A dot is marked at the intersection of column G and row 3.

A. Description of original monument and accessories and/or subsequent restoration:

- G-3: GLO 5/24/1846 B.F. Hall set post distance to G-2= 2658.74 (5)
Cedar 12" N28W 13 lk
Cedar 12" S32E 07 lk
LCRC 1-197 1975 L. Cavanagh 1/2" bar spike in fence corner N40E 46.4 N45W 60.7 Cedar (1)
LCRC 2-205 2/22/1993 T. Lapham 1/2" iron S45E 65.10 power pole (2) S10E 63.72 8" Poplar (3) N40W 51.20 fence corner South 33.0 capped iron (4)
Section break 11/18/1994 T. Lapham corner material not specified, no witnesses

B. Description of corner evidence found and/or method applied in restoring or reestablishing corner:


G-3: No evidence of GLO corner. Found 1/2" rod at centerline P.I. of road E-W and in centerline of road north on fence line south. Stream bank crosses fence line south at 175' 200' 280' and 330' south. GLO calls for stream at 5 ch. south. Apparent edge of swamp at 100' north and 100' east. GLO calls for 1 ch. north and 2 ch. east to leave swamp. Found iron is apparently "close" to GLO position but topographic calls do not clearly confirm or deny position. Found stump of witness (1), measured 61.1 to centerline of stump. Witness (2) has been replaced by new pole. Found very deteriorated stump of witness (3), measured 64' to centerline of stump. Found witness (4) at record distance. Distance (5) closely matches measured distance. Found witness (6) at record distance. Found witness (7), measured 67.15. Found witness (8), measured 102.10. Accepted found iron as best evidence of correct corner position.

C. Description of monument for corner and accessories established to perpetuate locating the position of the corner:

- G-3: Set 5/8"x36" rod with aluminum Ogemaw county remon. cap. Witnesses:
S05E 67.19 spike in E face of 14" Poplar
N35W 59.24 spike in NE face of new corner post
N47E 147.19 SW corner of block foundation for house
S45E 67.15 spike in NW face of power pole
S80W 102.10 spike in NW face of 6" W. Spruce
SOUTH 33.00 capped iron

Approved by Peer Review

12/15/98 DATE INITIALS

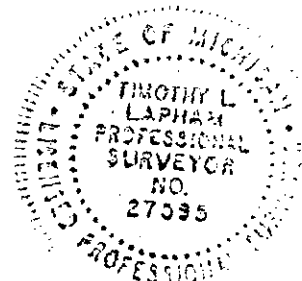

Signed by [Signature]
Surveyor's Michigan License No. 27595

Date 12/23/98