

SURVEY & REMONUMENTATION

APR 29 1996

COMMISSION

LAND CORNER RECORDATION CERTIFICATE
Filing Requirement of Act 74, Mich. P.A. 1970

For corners in

Ogemaw (County)	Located In:	Corner Code #
1. Public Land Survey	T21NR 1E	M-2
	T R	
	T R	
	T R	
2. Property Controlling In Section	S T R	
	S T R	
3. Miscellaneous Property in Sec.	S T R	
	S T R	

LIBER 3 PAGE 17

STATE OF MICHIGAN
OGEMAW COUNTY
RECORDED

28 DEC 95 3:19 P.M.

WANDA MUZIK
REGISTER OF DEEDS

Register of Deeds Stamp & File Number

4. Lot No. _____, Recorded Plat _____
5. Private Claims _____

I, Timothy L. Lapham, in a field survey on December, 1995 do hereby state that under requirements of P.A. 74, Michigan P.A. of 1970, the corner points mentioned in lines 1 and 2 above were in conformance with regulations and rules therefore as required in the current manual of survey instructions of the United States Department of the Interior, Bureau of Land Management or by a decree of a Court of Law and for that the corner points mentioned in lines 3, 4 and 5 above were in conformance with the rules of the Michigan Board of Land Surveyors or by a Decree of a Court of Law, established, re-established, monumented, recovered, found as expressed below:

NOTE: Not more than 2 corners, all in the same town and range, may be recorded on this certificate.

	A	B	C	D	E	F	G	H	I	J	K	L	M
1													
2		6		5		4		3		2		1	
3													
4		7		8		9		10		11		12	
5													
6		18		17		16		15		14		13	
7													
8		19		20		21		22		23		24	
9													
10		30		29		28		27		26		25	
11													
12		31		32		33		34		35		36	
13													

A. Description of original monument and accessories and/or subsequent restoration:

M-2: GLO Clason 1838, Set Post, 12" Beech S43E 38 lns, 10" Beech N32W 37 lns; Unrecorded Survey, Higgins, 9/24/81, No Mat, No Wits, Dist to North 2629.23; Unrecorded Section Division, Lapham, 1995, Found PK Nail at Fences, Dist to NE Sec 1 -2629.18', Dist to SE Sec 1 -2624.66, Angle on West Side of Line 179-28-26;


B. Description of corner evidence found and/or method applied in restoring or reestablishing corner:

M-2: No evidence of GLO found. Found 1/2" iron in line with fences East and West. Distances North and South within allowable limits. Accepted found corner as best evidence of the accepted position of the corner. See dossier for additional information.

APPROVED BY
PEER REVIEW
12/20/95 *TL*
DATE P.A. 345 of 1990

C. Description of monument for corner and accessories established to perpetuate locating the position of the corner:

M-2: Set 5/8"X36" rerod with 3-1/4" Aluminum Ogemaw Remon cap marked "27595 1995"
From Which:
N80E 40.13' 8" Steel Gate Post
East 39.45' Fence Corner w/spike
S10E 60.27' 10" Apple w/spike
West 35.50' Fence Corner w/spike

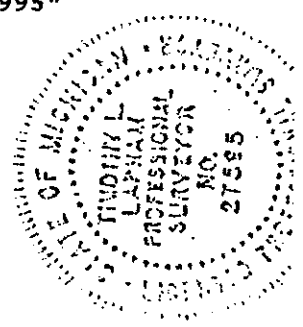

Signed by *Timothy L. Lapham*
Surveyor's Michigan License No. 27595

Date 12/20/95