

SURVEY & REMONUMENTATION

APR 29 1996

COMMISSION

LAND CORNER RECORDATION CERTIFICATE
Filing Requirement of Act 74, Mich. P.A. 1970

For corners in

Ogemaw (County)	Located In:	Corner Code #
1. Public Land Survey	T 21NR 1E	M-3
	T R	
	T R	
	T R	
2. Property Controlling In Section	S T R	
	S T R	
3. Miscellaneous Property in Sec.	S T R	
	S T R	

LIBER **3** PAGE **18**

STATE OF MICHIGAN
OGEMAW COUNTY
RECORDED

28 DEC 95 3:19 P.M.

WANDA MUZIK
REGISTER OF DEEDS

Register of Deeds Stamp & File Number

4. Lot No. _____, Recorded Plat _____
5. Private Claims _____

I, Timothy L. Lapham, in a field survey on December, 1995 do hereby state that under requirements of P.A. 74, Michigan P.A. of 1970, the corner points mentioned in lines 1 and 2 above were in conformance with regulations and rules therefore as required in the current manual of survey instructions of the United States Department of the Interior, Bureau of Land Management or by a decree of a Court of Law and/or that the corner points mentioned in lines 3, 4 and 5 above were in conformance with the rules of the Michigan Board of Land Surveyors or by a Decree of a Court of Law, established, re-established, monumented, recovered, found as expressed below:

NOTE: Not more than 2 corners, all in the same town and range, may be recorded on this certificate.

	A	B	C	D	E	F	G	H	I	J	K	L	M
1													
2		6		5		4		3		2		1	
3													
4		7		8		9		10		11		12	
5													
6		18		17		16		15		14		13	
7													
8		19		20		21		22		23		24	
9													
10		30		29		28		27		26		25	
11													
12		31		32		33		34		35		36	
13													

A. Description of original monument and accessories and/or subsequent restoration:

M-3: GLO Clason 1838, Set Post, 8" Hemlock N11W 12 lnks, 8" Hemlock S43W 23 lnks; Unrecorded Survey, Lapham 4/13/95, Found 1/2" iron, 5 Wits;

B. Description of corner evidence found and/or method applied in restoring or reestablishing corner:


M-3: No evidence of GLO Found. Found 1/2" iron bar at intersection of Rau and George Lake Roads. Found Lapham Witnesses. Accepted found corner as best evidence of the accepted position of the corner. See dossier for additional information.

APPROVED BY
PEER REVIEW

12/20/95 *TL*
DATE P.A. 345 of 1990

C. Description of monument for corner and accessories established to perpetuate locating the position of the corner:

M-3: Set 5/8" X 36" rerod with 3-1/4" Aluminum Ogemaw Remon cap marked "27595 1995"
From Which:
N69E 106.05' Utility Pole
S71E 79.83' Telephone Ped.
S42W 52.36' Telephone Ped.
N72W 132.98' Utility Pole
North 1.0' Centerline Rau Road

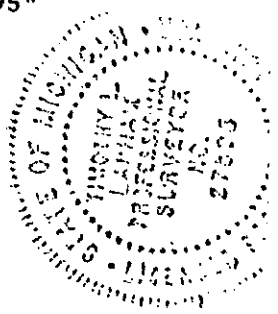

Signed by *Timothy L. Lapham*
Surveyor's Michigan License No. 27595

Date 12/28/95