

SURVEY & REMONUMENTATION

APR 29 1996

COMMISSION

LAND CORNER RECORDATION CERTIFICATE Filing Requirement of Act 74, Mich. P.A. 1970

For corners in

Ogemaw	Located In:	Corner Code #	
(County)			
1. Public Land Survey	T <u>21</u> N R <u>1E</u>	<u>M-8</u>	
	T <u> </u> R <u> </u>	<u> </u>	<u> </u>
	T <u> </u> R <u> </u>	<u> </u>	<u> </u>
	T <u> </u> R <u> </u>	<u> </u>	<u> </u>
2. Property Controlling In Section	S <u> </u> T <u> </u> R <u> </u>	<u> </u>	<u> </u>
	S <u> </u> T <u> </u> R <u> </u>	<u> </u>	<u> </u>
3. Miscellaneous Property in Sec.	S <u> </u> T <u> </u> R <u> </u>	<u> </u>	<u> </u>
	S <u> </u> T <u> </u> R <u> </u>	<u> </u>	<u> </u>

LIBER 3 PAGE 21

STATE OF MICHIGAN
OGEMAW COUNTY
RECORDED

28 DEC 95 3:20 P.M.

WANDA MUJIK
REGISTER OF DEEDS

Register of Deeds Stamp & File Number

4. Lot No. _____, Recorded Plat _____
5. Private Claims _____

I, Timothy L. Lapham, in a field survey on December, 1995 do hereby state that under requirements of P.A. 74, Michigan P.A. of 1970, the corner points mentioned in lines 1 and 2 above were in conformance with regulations and rules therefore as required in the current manual of survey instructions of the United States Department of the Interior, Bureau of Land Management or by a decree of a Court of Law and for that the corner points mentioned in lines 3, 4 and 5 above were in conformance with the rules of the Michigan Board of Land Surveyors or by a Decree of a Court of Law; established, re-established, monumented, recovered, found as expressed below:

	A	B	C	D	E	F	G	H	I	J	K	L	M
1													
2	6		5		4		3		2		1		
3													
4	7		8		9		10		11		12		
5													
6	18		17		16		15		14		13		
7													
8	19		20		21		22		23		24		
9													
10	30		29		28		27		26		25		
11													
12	31		32		33		34		35		36		
13													

NOTE: Not more than 2 corners, all in the same town and range, may be recorded on this certificate.

A. Description of original monument and accessories and/or subsequent restoration:

M-8: GLO Clason 1838, Set Post, 14" B. Ash S31W 12 lns, 12" Elm N78W 19 lns; Unrecorded Survey, Richardson, No Date, Fd. Pipe, 3 Wits; Plat, Lake George Subdivision, Richardson, 4/21/61(Rec 3-54), No Cor Mat, No Wits; Road Plans, Lapham, Set 1/2" LLS CI, 4 Wits; LCRC, Meyers, 11/30/90(Rec 2-110, 12/21/90), Set 1/2" CI, 3 Wits;

B. Description of corner evidence found and/or method applied in restoring or reestablishing corner:

M-8: No evidence of GLO survey found. Did not find iron at corner, found 1 Meyer witness, and 2 Lapham witness(1 duplicate). Set corner based on plat position and witnesses of record. Position agrees with road plans and Richardson survey North and South. Accepted established position as best evidence of the position of the accepted corner. See dossier for additional information.


APPROVED BY
PEER REVIEW

12/20/95 *JLL*

DATE P.A. 345 of 1990

C. Description of monument for corner and accessories established to perpetuate locating the position of the corner:

M-8: Set 5/8"X36" rerod with 3-1/4" Aluminum Ogemaw Remon cap marked "27595 1995"
From Which:
East 3.0' Centerline Channel Lake Road
S84E 36.80' 22" Elm with nail
S28E 72.55' 4" Ash with nail
S88W 33.05' Concrete Monument
N36W 76.81' Corner Fence post with nail
North 31.5' Centerline Elm Drive (West)

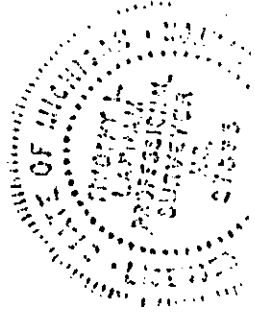

Signed by *Timothy L. Lapham*
Surveyor's Michigan License No. 27595

Date 12/20/95