SURVEY &
REMONUMENTATION

MAR 1 9 1998

OGEMAW COUNTY REMONUMENTATION

SECTION

For corners in
Ogemaw
(County)

LAND CORNER RECORDATION CERTIFICATE
Filing Requirement of Act 74, Mich. P.A. 1970

LIBER 3 PAGE 155
STATE OF MICHIGAN
OGEMAW COUNTY
RECORDED

26 Dec 1997 3:00:03 PM

WANDA MUZIK
REGISTER OF DEEDS

Register of Deeds Stamp & File Number

	Located In:	Corner Code #
1. Public Land Survey	T 21N R 1E	M-11
	T 21N R 2E	A-11
	T___ R___	
	T___ R___	
2. Property Controlling in Section	S___ T___ R___	
3. Miscellaneous Property in Sec.	S___ T___ R___	
	S___ T___ R___	
	S___ T___ R___	

4. Lot No. _____ , Recorded Plat _____
5. Private Claims _____

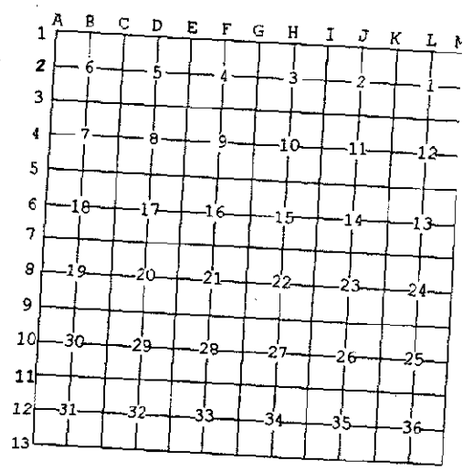

I, Timothy L. Lapham, in a field survey on December 11, 19 97 do hereby state that under requirements of P.A. 74, Michigan P.A. of 1970, the corner points mentioned in lines 1 and 2 above were in conformance with regulations and rules therefore as required in the current manual of survey instructions of the United States Department of the Interior, Bureau of Land Management or by a decree of a Court of Law and /or that the corner points mentioned in lines 3, 4 and 5 above were in conformance with the rules of the Michigan Board of Land Surveyors or by a Decree of a Court of Law; established, re-established, monumented, recovered, found as expressed below:

NOTE: Not more than 2 corners, all in the same town and range, may be recorded on this certificate.

A. Description of original monument and accessories and/or subsequent restoration:

GLO 1837 L. Clason set post
14" white birch S31W 20 Lk
8" cedar N53W 25 Lk

GLO 1846 Hall
10" hemlock S55E 15 Lk
12" maple N73E 30 Lk

1983 county road plans
Corner shown, no history

1993 Lapham Survey (N933212)
Found pinch pipe
S75W 53.25 6" poplar
S22E 49.66 fence corner
N76E 34.74 power pole

1995 Roser LCRC (L3, P52)
Rejected pinch pipe as set in error
Set 5/8" x 34" rerod w/ cap
6" white pine N5E 81.54
NW cor. cabin S75E 113.0

1995 Roser continued
13" cedar S70E 47.97
14" red pine S10E 78.87
6" balsam S50W 45.17
Co rd PI (5/8" rod) N89-43W 184.14

1997 Lapham Survey (N965716)
Corner not shown. Survey based on 1995 Roser corner

B. Description of corner evidence found and/or method applied in restoring or reestablishing corner:

No evidence of GLO corner.
Found 1993 Lapham corner and witnesses (Also on Co. Rd. Plans) and 1995 Roser corner and witnesses. 1993 corner is 114' +- North of Roser corner. Pinch pipe (1993 corner) was rejected because it was apparently set across the township line by a straight line between K-11, T21N R1E and C-11, T21N R2E. Occupation of roads and N 1/8 line fence in Sec 30, T21N, R2E indicate South corner should be used. Distances along township line validify South position.

Accepted Roser corner as best evidence of correct position of corner.

C. Description of monument for corner and accessories established to perpetuate locating the position of the corner:

Set 5/8"x36" rerod with 3-1/4" Aluminum Ogemaw Remon cap marked "27595 1997"
S75E 113.0 NW Corner of cabin
S70E 47.97 13" Cedar
S10E 78.87 14" Red Pine
S50W 45.17 6" Balsam

Approved by Peer Review
12-11-97 [illegible]
DATE INITIALS

Signed by [signature]
Surveyor's Michigan License No. 27595
Date 12/24/97

STATE OF MICHIGAN TIMOTHY L. LAPHAM PROFESSIONAL SURVEYOR NO. 27595 LICENSED PROFESSIONAL

FORM APPROVED BY MICHIGAN STATE BOARD OF PROFESSIONAL SURVEYORS, JAN. 28, 1971
REVISED MAY 14,1975
REVISED JAN., 1983
REVISED OCT. 1995