

STATE OF MICHIGAN
DEPARTMENT
OF
NATURAL RESOURCES

LAND CORNER RECORD

OGEMAW COUNTY


T 21 N R 2 E

DESCRIPTION OF CORNER N 1/16 on N-S 1/4 line

CORNER MONUMENT Set 1"x24" pipe

DATE MONUMENT PLACED AND WITNESSED 1-20-72

WITNESSES TO CORNER.....

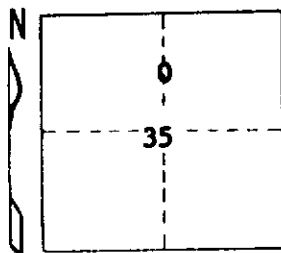

8" Maple S 30 W 13.9'


16" Tw. Maple N 81 W 20.0'

AND

CIRCLE CORNER REGISTERED

DESCRIPTION IN DETAIL AS TO HOW CORNER WAS LOCATED AND IDENTIFIED OR RESTORED.

Set by Standard survey procedure for subdivision of sections.

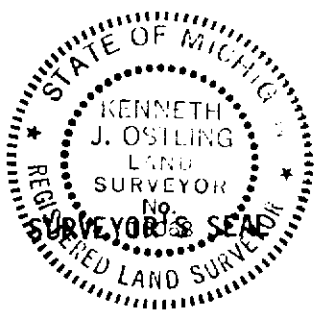

SIGNED Kenneth J. Osiling DATE 5-24-72
REGISTERED LAND SURVEYOR 10068

DISTRIBUTION:

County Courthouse
Area Forester (Regions I & II)
District or Region Surveyor
Forestry Div., Lansing

R 4047
Rev. 10/68