

STATE OF MICHIGAN
DEPARTMENT
OF
NATURAL RESOURCES

LAND CORNER RECORD

OGEMAW COUNTY


T 21 N R 2 E

DESCRIPTION OF CORNER 1/16 corner at Center of NW 1/4

CORNER MONUMENT Set 1"x24" pipe

DATE MONUMENT PLACED AND WITNESSED 1-20-72

WITNESSES TO CORNER..... 4" Bl Ash S 10 W 12.0'

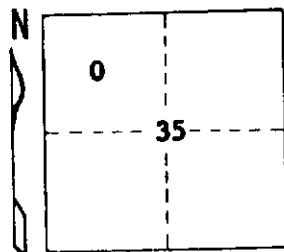

4" Balsam S 82 W 9.3'


23" W.P. Stp WEST 1.8'

AND

CIRCLE CORNER REGISTERED

DESCRIPTION IN DETAIL AS TO HOW CORNER WAS LOCATED AND IDENTIFIED OR RESTORED.

Set by standard survey procedure for the subdivision of sections.

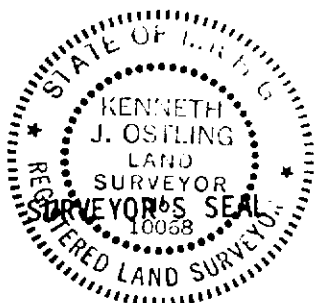

DISTRIBUTION:

SIGNED

Kenneth J. Ostling
REGISTERED LAND SURVEYOR
10068

DATE

5-24-72

County Courthouse
Area Forester (Regions I & II)
District or Region Surveyor
Forestry Div., Lansing

R 4047
Rev. 10/68