


STATE OF MICHIGAN  
DEPARTMENT  
OF  
NATURAL RESOURCES

LAND CORNER RECORD

OGEMAW COUNTY  
T 21 N R 2 E

DESCRIPTION OF CORNER Center 1/4 corner, Sec. 35  
CORNER MONUMENT Set 1"x24" pipe  
DATE MONUMENT PLACED AND WITNESSED 1-20-72  
WITNESSES TO CORNER..... 9" W. Birch S 35 W 27.2'

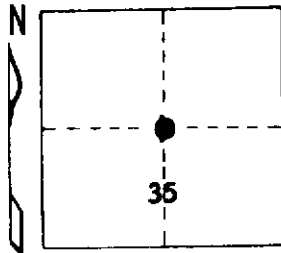


18" Trip. Maple N 52 W 55.7'  
Old fence corner WEST 15'  
AND

CIRCLE CORNER REGISTERED

DESCRIPTION IN DETAIL AS TO HOW CORNER WAS LOCATED AND IDENTIFIED OR RESTORED.

Set at calculated intersection of true 1/4 lines.

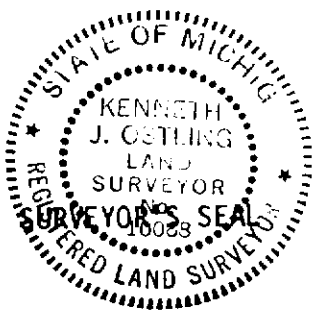

SIGNED Kenneth J. Ostling DATE 5-24-72  
REGISTERED LAND SURVEYOR 10068

DISTRIBUTION:

County Courthouse  
Area Forester (Regions I & II)  
District or Region Surveyor  
Forestry Div., Lansing

R 4047  
Rev. 10/68