

**SURVEY & REMONUMENTATION**

APR 29 1996

**COMMISSION LAND CORNER RECORDATION CERTIFICATE**  
 Filing Requirement of Act 74, Mich. P.A. 1970

For corners in

OGEMAW (County)	Located In:	Corner Code #
1. Public Land Survey	T <u>21NR</u> 2E	<u>A-5</u>
	T <u>    </u> R <u>    </u>	<u>    </u>
	T <u>    </u> R <u>    </u>	<u>    </u>
	T <u>    </u> R <u>    </u>	<u>    </u>
2. Property Controlling In Section	S <u>    </u> T <u>    </u> R <u>    </u>	<u>    </u>
	S <u>    </u> T <u>    </u> R <u>    </u>	<u>    </u>
3. Miscellaneous Property in Sec.	S <u>    </u> T <u>    </u> R <u>    </u>	<u>    </u>
	S <u>    </u> T <u>    </u> R <u>    </u>	<u>    </u>

LIBER **3** PAGE **13**  
 STATE OF MICHIGAN  
 OGEMAW COUNTY  
 RECORDED

28 DEC 95 3:15 P.M.

WANDA HUZIK  
 REGISTER OF DEEDS

Register of Deeds Stamp & File Number

4. Lot No. \_\_\_\_\_, Recorded Plat \_\_\_\_\_  
 5. Private Claims \_\_\_\_\_

I, TIMOTHY L. LAPHAM, in a field survey on December, 19 95 do hereby state that under requirements of P.A. 74, Michigan P.A. of 1970, the corner points mentioned in lines 1 and 2 above were in conformance with regulations and rules therefore as required in the current manual of survey instructions of the United States Department of the Interior, Bureau of Land Management or by a decree of a Court of Law and/or that the corner points mentioned in lines 3, 4 and 5 above were in conformance with the rules of the Michigan Board of Land Surveyors or by a Decree of a Court of Law; established, re-established, monumented, recovered, found as expressed below:

NOTE: Not more than 2 corners, all in the same town and range, may be recorded on this certificate.

	A	B	C	D	E	F	G	H	I	J	K	L	M
1													
2		6		5		4		3		2		1	
3													
4		7		8		9		10		11		12	
5													
6		18		17		16		15		14		13	
7													
8		19		20		21		22		23		24	
9													
10		30		29		28		27		26		25	
11													
12		31		32		33		34		35		36	
13													

A. Description of original monument and accessories and/or subsequent restoration:

A-5: CORNER IS COMMON WITH M-5 T21N R1E. SEE THAT CORNER FOR REMONUMENTATION INFORMATION.


B. Description of corner evidence found and/or method applied in restoring or reestablishing corner:

A-5: CORNER IS COMMON WITH M-5 T21N R1E. SEE THAT CORNER FOR REMONUMENTATION INFORMATION.

APPROVED BY  
 PEER REVIEW  
 12/20/95 *TL*  
 DATE P.A. 345 of 1990

C. Description of monument for corner and accessories established to perpetuate locating the position of the corner:

A-5: CORNER IS COMMON WITH M-5 T21N R1E. SEE THAT CORNER FOR REMONUMENTATION INFORMATION.

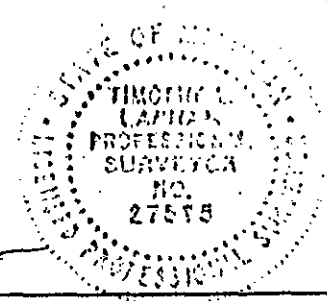

Signed by *Timothy L. Lapham*  
 Surveyor's Michigan License No. 27595

Date 12/28/95