

SURVEY & REMONUMENTATION

MAR 19 1998

OGEMAW COUNTY REMONUMENTATION

SECTION

LAND CORNER RECORDATION CERTIFICATE
Filing Requirement of Act 74, Mich. P.A. 1970

For corners in

<u>Ogemaw</u> (County)	Located in:	Corner Code #
1. Public Land Survey	T <u>21N</u> R <u>1E</u>	<u>M-11</u>
	T <u>21N</u> R <u>2E</u>	<u>A-11</u>
	T _____ R _____	_____
	T _____ R _____	_____
2. Property Controlling in Section	S _____ T _____ R _____	_____
	S _____ T _____ R _____	_____
3. Miscellaneous Property in Sec.	S _____ T _____ R _____	_____
	S _____ T _____ R _____	_____

LIBER **3** PAGE **155**
STATE OF MICHIGAN
OGEMAW COUNTY
RECORDED

26 Dec 1997 3:00:03 PM

WANDA MUZIK
REGISTER OF DEEDS

Register of Deeds Stamp & File Number

4. Lot No. _____, Recorded Plat _____
5. Private Claims _____

Timothy L. Lapham, in a field survey on December 11, 1997, do hereby state that under requirements of P.A. 74, Michigan P.A. of 1970, the corner points mentioned in lines 1 and 2 above were in conformance with regulations and rules therefore as required in the current manual of survey instructions of the United States Department of the Interior, Bureau of Land Management or by a decree of a Court of Law and/or that the corner points mentioned in lines 3, 4 and 5 above were in conformance with the rules of the Michigan Board of Land Surveyors or by a Decree of a Court of Law; established, re-established, monumented, recovered, found as expressed below:

NOTE: Not more than 2 corners, all in the same town and range, may be recorded on this certificate.

	A	B	C	D	E	F	G	H	I	J	K	L	M
1													
2	6		5		4		3		2		1		
3													
4	7		8		9		10		11		12		
5													
6	18		17		16		15		14		13		
7													
8	19		20		21		22		23		24		
9													
10	30		29		28		27		26		25		
11													
12	31		32		33		34		35		36		
13													

A. Description of original monument and accessories and/or subsequent restoration:

GLO 1837 L. Clason set post 14" white birch S31W 20 Lk 8" cedar N53W 25 Lk	1993 Lapham Survey (N933212) Found pinch pipe S75W 53.25 6" poplar S22E 49.66 fence corner N76E 34.74 power pole	1995 Roser continued 13" cedar S70E 47.97 14" red pine S10E 78.87 6" balsam S50W 45.17 Co rd PI (5/8" rod) N89-43W 184.14
GLO 1846 Hall 10" hemlock S55E 15 Lk 12" maple N73E 30 Lk	1995 Roser LCRC (L3, P52) Rejected pinch pipe as set in error Set 5/8" x 34" rerod w/ cap 6" white pine N5E 81.54 NW cor. cabin S75E 113.0	1997 Lapham Survey (N965716) Corner not shown. Survey based on 1995 Roser corner
1983 county road plans Corner shown, no history		

B. Description of corner evidence found and/or method applied in restoring or reestablishing corner:

No evidence of GLO corner.
Found 1993 Lapham corner and witnesses (Also on Co. Rd. Plans) and 1995 Roser corner and witnesses. 1993 corner is 114' +- North of Roser corner. Pinch pipe (1993 corner) was rejected because it was apparently set across the township line by a straight line between K-11, T21N R1E and C-11, T21N R2E. Occupation of roads and N 1/8 line fence in Sec 30, T21N, R2E indicate South corner should be used. Distances along township line validate South position.

Accepted Roser corner as best evidence of correct position of corner.


C. Description of monument for corner and accessories established to perpetuate locating the position of the corner:

Set 5/8"x36" rerod with 3-1/4" Aluminum Ogemaw Remon cap marked "27595 1997"
S75E 113.0 NW Corner of cabin
S70E 47.97 13" Cedar
S10E 78.87 14" Red Pine
S50W 45.17 6" Balsam

Approved by Peer Review

12-11-97 *WJL*
DATE INITIALS

Signed by *Timothy L. Lapham*
Surveyor's Michigan License No. 27595

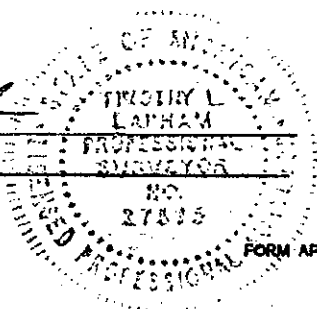

Date 12/24/97