

**SURVEY & REMONUMENTATION**

**MAR 19 1998**

**OGEMAW COUNTY REMONUMENTATION**

**SECTION**

**LAND CORNER RECORDATION CERTIFICATE**  
Filing Requirement of Act 74, Mich. P.A. 1970

For corners in

Ogemaw

(County)

Located in:

Corner Code #

1. Public Land Survey

T 21N R 1E M 12  
T 21N R 2E A-12  
T \_\_\_\_\_ R \_\_\_\_\_  
T \_\_\_\_\_ R \_\_\_\_\_  
T \_\_\_\_\_ R \_\_\_\_\_  
S \_\_\_\_\_ T \_\_\_\_\_ R \_\_\_\_\_  
S \_\_\_\_\_ T \_\_\_\_\_ R \_\_\_\_\_  
S \_\_\_\_\_ T \_\_\_\_\_ R \_\_\_\_\_  
S \_\_\_\_\_ T \_\_\_\_\_ R \_\_\_\_\_

2. Property Controlling in Section

3. Miscellaneous Property in Sec.

4. Lot No. \_\_\_\_\_, Recorded Plat \_\_\_\_\_

5. Private Claims \_\_\_\_\_

**LIBER 3 PAGE 142**  
STATE OF MICHIGAN  
OGEMAW COUNTY  
RECORDED

26 Dec 1997 2:55:30 PM

WANDA MUZIK  
REGISTER OF DEEDS

Register of Deeds Stamp & File Number

I, Timothy L. Lapham, in a field survey on December 11, 1997 do hereby state that under requirements of P.A. 74, Michigan P.A. of 1970, the corner points mentioned in lines 1 and 2 above were in conformance with regulations and rules therefore as required in the current manual of survey instructions of the United States Department of the Interior, Bureau of Land Management or by a decree of a Court of Law and /or that the corner points mentioned in lines 3, 4 and 5 above were in conformance with the rules of the Michigan Board of Land Surveyors or by a Decree of a Court of Law, established, re-established, monumented, recovered, found as expressed below:

NOTE: Not more than 2 corners, all in the same town and range, may be recorded on this certificate.

	A	B	C	D	E	F	G	H	I	J	K	L	M
1													
2	6		5		4		3		2		1		
3													
4	7		8		9		10		11		12		
5													
6	18		17		16		15		14		13		
7													
8	19		20		21		22		23		24		
9													
10	30		29		28		27		26		25		
11													
12	31		32		33		34		35		36		
13													

**A. Description of original monument and accessories and/or subsequent restoration:**

GLO 1837 L. Clason set post  
8" cedar S54W 15 Lk  
6" cedar N78W 22 Lk

1995 Roser LCRC (L3, P52)  
Set 5/8" x 34" rerod w/cap  
5" twin maple S30W 34.1  
Power pole N80E 39.45  
9" maple S35W 29.6  
3" ash S75W 32.0  
Cedar post East 25'

**B. Description of corner evidence found and/or method applied in restoring or reestablishing corner:**

No evidence of GLO corner. Found Roser 1995 corner witnesses and 1-1/4" pipe 57' South of same. Pipe of unknown origin. Reset Roser corner which is in the center of the N-S road on a fence line East (just remains of old fence). Dimensions along township line are close to GLO and verify Roser corner.

Accepted Roser corner as best evidence of correct corner position.

**C. Description of monument for corner and accessories established to perpetuate locating the position of the corner:**

Set 5/8"x36" rerod with 3-1/4" Aluminum Ogemaw Remon marked "27595 1997"  
S30W 34.1 5" Twin Maple  
N80E 39.45 Power Pole  
S35W 29.6 9" Maple  
S75W 32.0 3" Ash  
East 25' Cedar post

Approved by Peer Review


Dillon SR  
DATE INITIALS

Signed by

*[Signature]*

Surveyor's Michigan License No.

27595

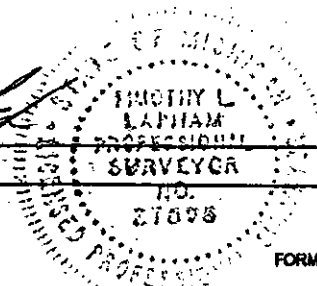

Date

12/29/97