

SURVEY & REMONUMENTATION

MAR 19 1998

OGEMAW COUNTY REMONUMENTATION

LAND CORNER RECORDATION CERTIFICATE Filing Requirement of Act 74, Mich. P.A. 1970

SECTION

For corners in

Ogemaw (County)	Located In:	Corner Code #
1. Public Land Survey	T 21N R 2E	C-1
	T R	
	T R	
	T R	
2. Property Controlling in Section	S T R	
	S T R	
3. Miscellaneous Property in Sec.	S T R	
	S T R	

LIBER 3 PAGE 145
STATE OF MICHIGAN
OGEMAW COUNTY
RECORDED

26 Dec 1997 2:56:33 PM

WANDA MUZIK
REGISTER OF DEEDS
Register of Deeds Stamp & File Number

4. Lot No. _____, Recorded Plat _____
5. Private Claims _____

I, Timothy L. Lapham, in a field survey on November 20 19 97 do hereby state that under requirements of P.A. 74, Michigan P.A. of 1970, the corner points mentioned in lines 1 and 2 above were in conformance with regulations and rules therefore as required in the current manual of survey instructions of the United States Department of the Interior, Bureau of Land Management or by a decree of a Court of Law and /or that the corner points mentioned in lines 3, 4 and 5 above were in conformance with the rules of the Michigan Board of Land Surveyors or by a Decree of a Court of Law, established, re-established, monumented, recovered, found as expressed below:

NOTE: Not more than 2 corners, all in the same town and range, may be recorded on this certificate.

	A	B	C	D	E	F	G	H	I	J	K	L
1												
2	6		5		4		3		2		1	
3												
4	7		8		9		10		11		12	
5												
6	18		17		16		15		14		13	
7												
8	19		20		21		22		23		24	
9												
10	30		29		28		27		26		25	
11												
12	31		32		33		34		35		36	
13												

A. Description of original monument and accessories and/or subsequent restoration:

GLO B.F. Hall 1846 set post
Birch 10" S42E 21 lk
B. Ash 10" S44W 42 lk
Falls 29 lks W of standard corner

Slattery 1965 LCRC (L1, P88) MSHD
Set 4" steel fence post, 20'+ West
of centerline Cook Rd at fence West
S55E 59.97 Corner fence post
S85W 68.39 20" Elm
N30W 15.40 tag in top of 12" stump
S89° 49' 36" E 19.02 SW cor Sec 32, 22N2E

T. Lapham 1991 Survey (N912180)
Found iron
N89E 19.02 monument box
N09W 96.43 sign post
N70E 100.76 2nd post on N guard rail
S85E 93.19 1st post on S guard rail

D. Ledy 1988 Survey (L4, P228)
Corner ref as 19.02' W of C-13, 22N, 2E

B. Description of corner evidence found and/or method applied in restoring or reestablishing corner:

No evidence of GLO corner.
Found 1/2" boat spike in mon box in centerline Cook Rd. (BR 1-75) and capped iron in concrete pavement 19.03 West
All witnesses prior to 1977 are gone, apparently due to construction of 1-75. West iron used as C-1 in subsequent records.
Corner reference (C-1 to C-13, 22N2E) from 1965, 1988 and 1991 all match and are as measured in 1997. All 1991 Lapham witnesses were found.
Found capped iron accepted as best evidence of correct corner position.


C. Description of monument for corner and accessories established to perpetuate locating the position of the corner:

FOUND 1/2" DIAMETER CAPPED IRON (P.S. NUMBER OBLITERATED)
EAST 19.03 3-1/4" Aluminum Ogemaw Remon cap in monument box
N09W 76.83 sign post E leg
N77E 100.95 2nd post on N guard rail
S78E 93.38 1st post on S guard rail
S57E 59.2 Centerline one way traffic post
N53E 79.7 Centerline one way traffic post

Approved by Peer Review

DATE INITIALS

Signed by [Signature]
Surveyor's Michigan License No. 27595

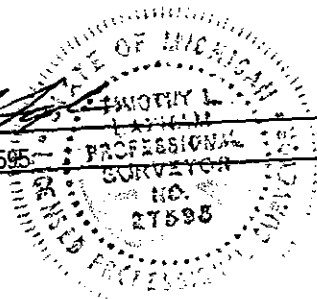

Date 12/24/97