

Ogemaw County Remonumentation
LAND CORNER RECORDATION CERTIFICATE
 Filing Requirement of Act 74, Mich. P.A. 1970

PROPERTY &
 RECORDS

FEB 24 2000

For corners in

<u>Ogemaw</u> (County)	Located in:	Corner Code #
1. Public Land Survey	T21N R02E	C-9
	T R	
	T R	
	T R	
2. Property Controlling in Section	S T R	
	S T R	
3. Miscellaneous Property in Sec.	S T R	
	S T R	

SECTION



3006804
 Page: 1 of 1
 12/27/1999 09:09A
 L-4 P-13
 Manda Muzik, Ogemaw Co. Register SURC 9.00

Register of Deeds Stamp & File Number

4. Lot No. _____, Recorded Plat _____
 5. Private Claims _____

I, Timothy L Lapham, in a field survey on December, 19 99 do hereby state that under requirements of P.A. 74, Michigan P.A. of 1970, the corner points mention in lines 1 and 2 above were in conformance with regulations and rules therefore as required in the current manual of survey instructions of the United States Department of the Interior, Bureau of Land Management or by a decree of a Court of Law and/or that the corner points mentioned in lines 3, 4 and 5 above were in conformance with the rules of the Michigan Board of Land Surveyors or by a Decree of a Court of Law; established, re-established, monumented, recovered, found as expressed below:

NOTE: Not more than 2 corners, all in the same town and range, may be recorded on this certificate

	A	B	C	D	E	F	G	H	I	J	K	L	M
1													
2	6		5		4		3		2		1		
3													
4	7		8		9		10		11		12		
5													
6	18		17		16		15		14		13		
7													
8	19		20		21		22		23		24		
9													
10	30		29		28		27		26		25		
11													
12	31		32		33		34		35		36		
13													

A. Description of original monument and accessories and/or subsequent restoration:

- C-9: GLO by B.F. Hall, 1846, Post
 NSW 13 10' Cedar
 S30W 6 10' Cedar
- LCRC by M. Kovisto, 1965, Found 1/2" Iron rod
 N50W 39.11 Cor Fe Post
 N50E 40.53 Cor Fe Post
 S58E 57.07 Tel Pole
- County Road Plans, 1998, Found 5/8" Iron
 N35E 83.88 8" Elm
 S58E 73.38 10" Elm
 S16E 95.59 8" Ash

Approved by Peer Review


12/23/99 DATE JLL INITIALS

B. Description of corner evidence found and/or method applied in restoring or reestablishing corner:

C-9: No GLO evidence found. No evidence of 1965 witnesses found. Found 5/8" Iron in centerline of Cook Road at center line of Wicks Road in accord with 1965 records and per 1998 county road plans. Accepted found iron as best evidence of correct corner position.

C. Description of monument for corner and accessories established to perpetuate locating the position of the corner:

- C-9: Set 5/8"x3/4" rerod w/ aluminum remon cap
 N70E 83.78 Guide Pole
 S58E 73.38 10" Elm
 S16E 95.59 8" Ash
 N45W 43.85 Utility Pole

 

Drawn by [Signature]
 Surveyor's Michigan License No. 27595

Date 12/23/1999