

**SURVEY &  
REMONUMENTATION**

MAR 19 1998

OGEMAW COUNTY REMONUMENTATION

**LAND CORNER RECORDATION CERTIFICATE**  
Filing Requirement of Act 74, Mich. P.A. 1970

For corners in **SECTION**

<u>Ogemaw</u> (County)	Located In:	Corner Code #
1. Public Land Survey	T21N R 2E	F-1
	T___ R___	_____
	T___ R___	_____
	T___ R___	_____
2. Property Controlling in Section	S___ T___ R___	_____
	S___ T___ R___	_____
3. Miscellaneous Property in Sec.	S___ T___ R___	_____
	S___ T___ R___	_____

LIBER 3 PAGE 135  
STATE OF MICHIGAN  
OGEMAW COUNTY  
RECORDED

26 Dec 1997 2:52:35 PM

WANDA MUZIK  
REGISTER OF DEEDS

Register of Deeds Stamp & File Number

4. Lot No. \_\_\_\_\_, Recorded Plat \_\_\_\_\_  
5. Private Claims \_\_\_\_\_

I, Timothy L. Lapham, in a field survey on November 20, 1997 do hereby state that under requirements of P.A. 74, Michigan P.A. of 1970, the corner points mentioned in lines 1 and 2 above were in conformance with regulations and rules therefore as required in the current manual of survey instructions of the United States Department of the Interior, Bureau of Land Management or by a decree of a Court of Law and/or that the corner points mentioned in lines 3, 4 and 5 above were in conformance with the rules of the Michigan Board of Land Surveyors or by a Decree of a Court of Law; established, re-established, monumented, recovered, found as expressed below:

1	A	B	C	D	E	F	G	H	I	J	K	L	M
2		6		5		4		3		2		1	
3													
4		7		8		9		10		11		12	
5													
6		18		17		16		15		14		13	
7													
8		19		20		21		22		23		24	
9													
10		30		29		28		27		26		25	
11													
12		31		32		33		34		35		36	
13													

NOTE: Not more than 2 corners, all in the same town and range, may be recorded on this certificate.

- A. Description of original monument and accessories and/or subsequent restoration:
- Not set by GLO
  - T. Lapham 1985 Survey (N850326)  
Set capped iron  
N10W 32.89 fence post  
S05E 51.07 Maple cluster  
S60W 70.95 12" Oak  
East 1.32 S 1/4 cor 33, 22N, 2E
  - T. Lapham 1995 Survey (N954871)  
Found capped iron, same witnesses as 1985 Lapham survey
  - T. Lapham 1996 Survey (N965638)  
Referenced corner, no witnesses

B. Description of corner evidence found and/or method applied in restoring or reestablishing corner:  
Found 2 iron 1.32' apart. East iron is on fence line North and on West edge of cleared land for pipeline North. No evidence of fence line South. Either iron could be on East line of cleared land for pipeline to South. East iron has been used as corner F-13, T22N R2E. West iron was set in 1985 by Lapham by Single Proportionate Measure for corner F-1. Current measurements verify SPM. Accepted found iron as careful establishment of correct position of GLO corner.


C. Description of monument for corner and accessories established to perpetuate locating the position of the corner:

- Set 5/8"x36" rerod with 3-1/4" Aluminum Ogemaw Remon cap marked "27595 1997"
- N18W 32.8+/- Old cedar post poor condition
- S62W 71.03 14" Oak
- East 1.32 5/8"x36" rerod with 3-1/4" Aluminum Ogemaw Remon cap
- N56W 58.39 Nail in top centerline fence brace post
- N04E 32.39 Nail in top centerline corner fence post (N, E & W)
- S25E 42.63 6" Maple
- S26W 54.09 10" Basswood

Approved by Peer Review

11-20-97 *[Signature]*  
DATE INITIALS

Signed by *[Signature]*  
Surveyor's Michigan License No. 27595

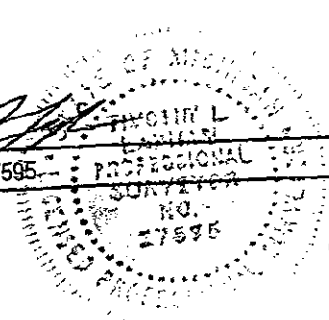

Date 12/24/97