

**SURVEY &  
REMONUMENTATION**

**MAR 19 1998**

**OGEMAW COUNTY REMONUMENTATION**

**SECTION**

**LAND CORNER RECORDATION CERTIFICATE  
Filing Requirement of Act 74, Mich. P.A. 1970**

For corners in  
Ogemaw

Located in: Corner Code #

**LIBER 3 PAGE 151**

STATE OF MICHIGAN  
OGEMAW COUNTY  
RECORDED

26 Dec 1997 2:58:36 PM

WANDA MUZIK  
REGISTER OF DEEDS

Register of Deeds Stamp & File Number

1. Public Land Survey	T	21N	R	2E	H-1
	T		R		
	T		R		
	T		R		
2. Property Controlling in Section	S		T	R	
	S		T	R	
3. Miscellaneous Property in Sec.	S		T	R	
	S		T	R	

4. Lot No. \_\_\_\_\_, Recorded Plat \_\_\_\_\_  
5. Private Claims \_\_\_\_\_

	A	B	C	D	E	F	G	H	I	J	K	L
1												
2	6			5			4		3			2
3												
4	7			8			9		10		11	12
5												
6	18			17			16		15		14	13
7												
8	19			20			21		22		23	24
9												
10	30			29			28		27		26	25
11												
12	31			32			33		34		35	36
13												

Timothy L. Lapham, in a field survey on November 20, 1997 do hereby state that under requirements of P.A. 74, Michigan P.A. of 1970, the corner points mentioned in lines 1 and 2 above were in conformance with regulations and rules therefore as required in the current manual of survey instructions of the United States Department of the Interior, Bureau of Land Management or by a decree of a Court of Law and/or that the corner points mentioned in lines 3, 4 and 5 above were in conformance with the rules of the Michigan Board of Land Surveyors or by a Decree of a Court of Law; established, re-established, monumented, recovered, found as expressed below:

NOTE: Not more than 2 corners, all in the same town and range, may be recorded on this certificate.

A. Description of original monument and accessories and/or subsequent restoration:  
Not set by GLO

No surveys or LCRC's recorded indicate corner being set.

T. Lapham 1989 Survey (N891326)  
North line of Section 3 shown as straight line from G-1 to I-1

B. Description of corner evidence found and/or method applied in restoring or reestablishing corner:

A 1/2" rerod was found that had been used as the S 1/4 corner of Section 34, T22N, R2E. No other irons or evidence of occupation were found for this corner. The corner position was set by single proportionate measure falling 6.08' West of the H-13, T22N, R2E position. Accepted this position as careful establishment of a corner not set during the GLO survey.


Approved by Peer Review

11-20-97 W JBR  
DATE INITIALS

C. Description of monument for corner and accessories established to perpetuate locating the position of the corner:

- Set 5/8"x36" rerod with 3-1/4" Aluminum Ogemaw Remon cap marked "27595 1997"
- N08W 43.10 8" Maple
- S51W 62.05 8" W. Pine
- N39E 47.25 12" W. Pine
- S41E 64.60 24" W. Pine
- EAST 6.08 5/8"x36" rerod with 3-1/4" Aluminum Ogemaw Remon cap

Signed by [Signature]  
Surveyor's Michigan License No. 27595

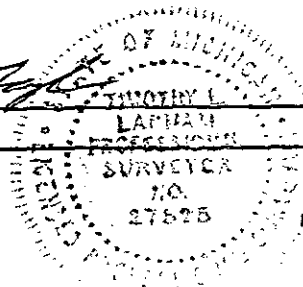

Date 12/24/97