

**SURVEY & REMONUMENTATION**

MAR 19 1998

**OGEMAW COUNTY REMONUMENTATION**

**LAND CORNER RECORDATION CERTIFICATE**  
Filing Requirement of Act 74, Mich. P.A. 1970

**SECTION**

For corners in

Ogemaw

(County)

Located In:

Corner Code #

		T 21N	R 2E	J-1
1. Public Land Survey		T	R	_____
		T	R	_____
		T	R	_____
		T	R	_____
2. Property Controlling in Section	S	T	R	_____
	S	T	R	_____
3. Miscellaneous Property in Sec.	S	T	R	_____
	S	T	R	_____

**LIBER 3 PAGE 150**  
STATE OF MICHIGAN  
OGEMAW COUNTY  
RECORDED

26 Dec 1997 2:58:12 PM

WANDA MUZIK  
REGISTER OF DEEDS  
Register of Deeds Stamp & File Number

4. Lot No. \_\_\_\_\_, Recorded Plat \_\_\_\_\_  
5. Private Claims \_\_\_\_\_

I, Timothy L. Lapham, in a field survey on November 20, 1997 do hereby state that under requirements of P.A. 74, Michigan P.A. of 1970, the corner points mentioned in lines 1 and 2 above were in conformance with regulations and rules therefore as required in the current manual of survey instructions of the United States Department of the Interior, Bureau of Land Management or by a decree of a Court of Law and/or that the corner points mentioned in lines 3, 4 and 5 above were in conformance with the rules of the Michigan Board of Land Surveyors or by a Decree of a Court of Law; established, re-established, monumented, recovered, found as expressed below:

**NOTE:** Not more than 2 corners, all in the same town and range, may be recorded on this certificate.

1	A	B	C	D	E	F	G	H	I	J	K	L	M
2		6		5		4		3		2		1	
3													
4		7		8		9		10		11		12	
5													
6		18		17		16		15		14		13	
7													
8		19		20		21		22		23		24	
9													
10		30		29		28		27		26		25	
11													
12		31		32		33		34		35		36	
13													

**A. Description of original monument and accessories and/or subsequent restoration:**  
GLO not set  
Richardson 1970 Survey noted all evidence in area of corner destroyed with building over probable corner position. Corner position calculated on line between I-1 and M-1 at midpoint of line I-1 to K-1.  
Cavanagh 1974 Survey (L1, P403) Corner not referenced but bearings and dimensions match Richardson 1970 survey.  
Ledy 1984 Survey (L8, P529) Corner not referenced but bearings on N-S 1/4 line and E-W 1/4 line match Richardson survey.

**B. Description of corner evidence found and/or method applied in restoring or reestablishing corner:**  
Two irons were found which appeared to be intended as I-13, 22N, R2E. Both were rejected. There was no occupation indicating the position of this corner East and West. The corner was set in accord with the 1970 Richardson survey at single proportionate measure between I-1 and K-1. The set corner is presented as the careful establishment of a corner not set in the GLO survey.


Approved by Peer Review

11-20-98 *JLR*  
DATE INITIALS

**C. Description of monument for corner and accessories established to perpetuate locating the position of the corner:**

- Set 5/8"x36" rerod with 3-1/4" Aluminum Ogemaw Remon cap marked "27595 1997"
- S16W 138.46 Power pole
- N16W 38.54 10" W. Pine
- S36E 154.68 14" twin W. Pine
- N60E 126.56 9" W. Pine
- East 9.24 5/8"x36" rerod with 3-1/4" Aluminum Ogemaw Remon cap (J-13, T22N, R2E)

Signed by *Timothy L. Lapham*  
Surveyor's Michigan License No. 27595

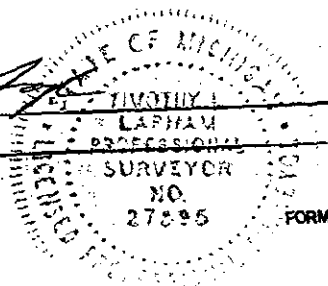

Date 12/24/97