

SURVEY & REMONUMENTATION

MAR 19 1998

SECTION

OGEMAW COUNTY REMONUMENTATION

LAND CORNER RECORDATION CERTIFICATE
Filing Requirement of Act 74, Mich. P.A. 1970

For corners in

<u>Ogemaw</u> (County)	Located in:	Corner Code #
	T <u>21N</u> R <u>2E</u>	<u>K-1</u>
1. Public Land Survey	T _____ R _____	_____
	T _____ R _____	_____
	T _____ R _____	_____
	T _____ R _____	_____
2. Property Controlling in Section	S _____ T _____ R _____	_____
	S _____ T _____ R _____	_____
3. Miscellaneous Property in Sec.	S _____ T _____ R _____	_____
	S _____ T _____ R _____	_____

LIBER 3 PAGE 149
STATE OF MICHIGAN
OGEMAW COUNTY
RECORDED

26 Dec 1997 2:57:56 PM

WANDA MUZIK
REGISTER OF DEEDS

Register of Deeds Stamp & File Number

4. Lot No. _____, Recorded Plat _____
5. Private Claims _____

I, Timothy L. Lapham, in a field survey on November 20, 1997 do hereby state that under requirements of P.A. 74, Michigan P.A. of 1970, the corner points mentioned in lines 1 and 2 above were in conformance with regulations and rules therefore as required in the current manual of survey instructions of the United States Department of the Interior, Bureau of Land Management or by a decree of a Court of Law and /or that the corner points mentioned in lines 3, 4 and 5 above were in conformance with the rules of the Michigan Board of Land Surveyors or by a Decree of a Court of Law; established, re-established, monumented, recovered, found as expressed below:

NOTE: Not more than 2 corners, all in the same town and range, may be recorded on this certificate.

A	B	C	D	E	F	G	H	I	J	K	L	M
1												
2	6		5		4		3		2		1	
3												
4	7		8		9		10		11		12	
5												
6	18		17		16		15		14		13	
7												
8	19		20		21		22		23		24	
9												
10	30		29		28		27		26		25	
11												
12	31		32		33		34		35		36	
13												

A. Description of original monument and accessories and/or subsequent restoration:

- GLO BF Hall, 1846
- B. ash 10" S31E 16 Lk
- B. ash 18" S67W 6 Lk
- set post 18 Lk W of standard post
- CP Co. (H. Dorcey) 1968+- No witnesses
- Sect breaks of 36, 22N, 2E and I-21, N2E
- J. Richardson 9/1970 no cor established
- Position determined on line from I-13 to M-13 of 22N 2E and on fence line S
- D. Ledy LCRC 2-100, 10/1989
- Set 2" pipe 7' long in centerline +- river
- NE 40.92 8" trip ash
- NW 40.25 4" ash
- SE 56.95 6" ash
- SW 46.85 12" ash
- East 11.88 K-13, 22N 2E

B. Description of corner evidence found and/or method applied in restoring or reestablishing corner:


No GLO evidence found for corner. Ledy corner gone but witnesses intact. An axle shaft was found for Ledy K-13, 22N 2E. A 1" iron bar was found 7.54 W of axle shaft or 4.34' E of Ledy position for K-1. Richardson position approximately 5' South and 11' West of Ledy position. C.P. Co. position approximately 14' North of Ledy position. GLO stream calls inconclusive in determining position (stream has apparently moved). Richardson position accepted as best evidence of original position of corner.

C. Description of monument for corner and accessories established to perpetuate locating the position of the corner:

Set 5/8"x36" rerod with 3-1/4" Aluminum Ogemaw Remon cap marked "27595 1997" at reference corner 164.81 feet West of corner along section line. Corner falls in river. From reference corner:
 N30W 46.59 15" Ash
 N64W 65.98 20" Ash
 S2W 34.78 8" Ash
 S34E 49.95 14" Ash
 East* 276.58 reference corner to K-13, T21N, R3E
 (*East along section line)

Approved by Peer Review
 [Signature] [Signature]
 NAME INITIALS

Signed by [Signature]
 Surveyor's Michigan License No. 27595

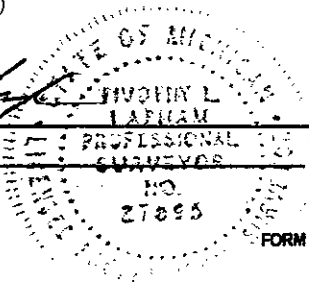

Date 12/24/97