

SURVEY & REMONUMENTATION

MAR 19 1998

OGEMAW COUNTY REMONUMENTATION

LAND CORNER RECORDATION CERTIFICATE
Filing Requirement of Act 74, Mich. P.A. 1970

SECTION

For corners in

<u>Ogemaw</u> <small>(County)</small>	Located in:	Corner Code #
1. Public Land Survey	T 21N R 2E	M-1 ✓
	T 22N R 2E	M-13
	T 21N R 3E	A-1
	T 22N R 3E	A-13
2. Property Controlling in Section	S ___ T ___ R ___	___
	S ___ T ___ R ___	___
3. Miscellaneous Property in Sec.	S ___ T ___ R ___	___
	S ___ T ___ R ___	___

LIBER 3 PAGE 124
STATE OF MICHIGAN
OGEMAW COUNTY
RECORDED
26 Dec 1997 2:49:53 PM
WANDA MUZIK
REGISTER OF DEEDS

Register of Deeds Stamp & File Number

4. Lot No. _____, Recorded Plat _____
5. Private Claims _____

I, Timothy L. Lapham, in a field survey on November 20 19 97 do hereby state that under requirements of P.A. 74, Michigan P.A. of 1970, the corner points mentioned in lines 1 and 2 above were in conformance with regulations and rules therefore as required in the current manual of survey instructions of the United States Department of the Interior, Bureau of Land Management or by a decree of a Court of Law and /or that the corner points mentioned in lines 3, 4 and 5 above were in conformance with the rules of the Michigan Board of Land Surveyors or by a Decree of a Court of Law, established, re-established, monumented, recovered, found as expressed below:

NOTE: Not more than 2 corners, all in the same town and range, may be recorded on this certificate.

A. Description of original monument and accessories and/or subsequent restoration:

GLO 1838 L. Clason set post Sp. pine 10" S19W 36 Lk Sp. pine 10" N56E 100 Lk	J. Richardson not dated, replaced per MSHD plans, 1/2" bar 12" Oak N15E 87.02 10" Oak S32 1/2E 58.14 (state) 10" Oak N67E 63.47 (state) 12" Oak N39E 57.94	LCRC 1-315, T. Lapham, 12/1984, found 3/4" steel rod N15E 87.02 12" Oak S30E 58.00 12" Oak N45E 58.09 12" Oak N80E 56.67 14" Oak S80E 32.83 10" Oak West 47.34 P.K. nail centerline M-33
--	---	---

(CONTINUED ON BACK)

B. Description of corner evidence found and/or method applied in restoring or reestablishing corner:

Found railroad spike in 1" pipe. Material does not match any records. No evidence of GLO Remains.
MDOT, found SE wit and stump of NE wit.
C.P. Co., found SE wit, NE wit gone, ROW marker gone.
Richardson, found 3 wits and stump (NOTE).
Lapham, found 5 wits, PK gone.
Ledy, found 2 wits, NW wit found N40E, NWN wit found N72E
All records indicate same position for corner with no history back to GLO.
Accepted found iron as best evidence of corner position.


Approved by Peer Review
Wanda Muzik JL
DATE INITIALS

C. Description of monument for corner and accessories established to perpetuate locating the position of the corner:

Set 5/8"x36" rerod with 3-1/4" Aluminum Ogemaw Remon cap marked "27595 1997" in 1" Pipe
S30E 58.00 MDOT tag in 14" Oak
S74E 32.85 MDOT tag in 8" Trip. Oak
N72E 56.74 MDOT tag in 16" Oak
N40E 58.01 MDOT tag in 12" Oak
N18E 87.03 Spike in 14" Doub. Oak
West 48.4 Centerline pavement M-33

Signed by [Signature]
Surveyor's Michigan License No. 27595

Date 12/24/97

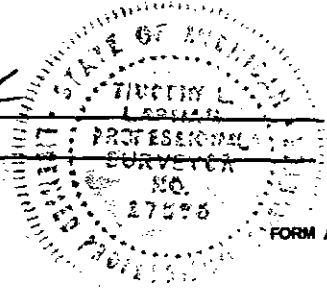

T2N, R2E

M-1 (page 2)

LIDER 3 PAGE 125

Survey (4-360.72) D. Ledy 2/1990
Fd. 3/4" rod 48.2 E. of centerline M-33
SE 57.98 10" Oak
S85E 32.96 8" Tri. Oak
NW 57.96 8" Oak
WNW 56.69 12" Oak

Consumers Power Survey undated
1/2" iron pin
Highway ROW marker East 27.57
8" Oak NE 57.96
8" Oak SE 58.20

Ogeman Co.