

# LAND CORNER RECORDATION CERTIFICATE

Filing Requirement of Act 74, Mich. PA 1970

For Corners In: Ogemaw (County)	Located In	Corner Code #
1. Public Land Survey	T _____ R _____	_____
	T _____ R _____	_____
2. Property Controlling in Section	S <u>17</u> T <u>21N</u> R <u>2E</u>	<u>11</u>
	S <u>17</u> T <u>21N</u> R <u>2E</u>	<u>12</u>
3. Miscellaneous Property in Section	S _____ T _____ R _____	_____
	S _____ T _____ R _____	_____


Register of Deeds Stamp & File Number

4. Lot No: \_\_\_\_\_ Recorded Plat: \_\_\_\_\_

5. Private Claims: \_\_\_\_\_

I, Carl T. Kiiskila, in a field survey on January, 2000 do hereby state that under requirements of PA 74, Michigan PA of 1970, the corner points mentioned in lines 1 and 2 above were in conformance with regulations and rules therefore as required in the current manual of survey instructions of the United States Department of the Interior, Bureau of Land Management or by a decree of a Court of Law and/or that the corner points mentioned in lines 3, 4 and 5 above were in conformance with the rules of the Michigan Board of Land Surveyors or by a Decree of a Court of Law; established, re-established, monumented, recovered, found as expressed below:

**NOTE: Not more than 2 corners, all in the same town and range, may be recorded on this certificate.**

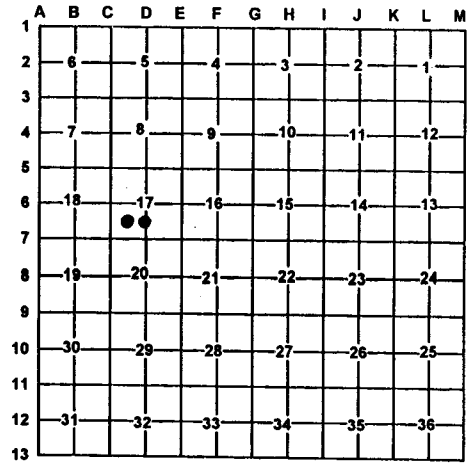

**A. Description of original monument and accessories and/or subsequent restoration:**

11- This corner position was not established during the original government survey.

12- This corner position was not established during the original government survey.

**B. Description of corner evidence found and/or method applies in restoring or re-establishing corner:**

11- Found 5/8" rerod with P.S. cap #43048

12- Set 5/8" X 32" rerod with P.S. cap #33981

**C. Description of monument for corner and accessories established to perpetuate locating the position of the corner:**

11- 5/8" Rerod with P.S. cap #43048  
 Wit: 16" Twin White Birch S12°E 67.35'  
 12" White Birch S75°W 37.95'  
 12" White Birch N41°W 67.17'  
 5" Cherry N67°E 36.77'  
 Carsonite Post North 1±

12- 5/8" X 32" Rerod with P.S. cap #33981  
 Wit: 7" Ash N08°W 15.60'  
 7" Ash S68°E 18.56'  
 3" Ash S15°W 17.81'  
 5" Ash N07°W 15.13'  
 Carsonite post North 1±

Signed by: Carl T. Kiiskila  
 Surveyor's Michigan License No.: 33981

Date: 4/4/00

