

LAND CORNER RECORDATION CERTIFICATE

Filing Requirement of Act 74, Mich. PA 1970

For Corners In: Ogemaw (County)	Located In	Corner Code #
1. Public Land Survey	T <u>21N</u> R <u>2E</u>	<u>C-7</u>
	T <u>21N</u> R <u>2E</u>	<u>D-7</u>
2. Property Controlling in Section	S _____ T _____ R _____	_____
	S _____ T _____ R _____	_____
3. Miscellaneous Property in Section	S _____ T _____ R _____	_____
	S _____ T _____ R _____	_____


Register of Deeds Stamp & File Number

4. Lot No: _____ Recorded Plat: _____

5. Private Claims: _____

I, Carl T. Kiiskila, in a field survey on January, 2000 do hereby state that under requirements of PA 74, Michigan PA of 1970, the corner points mentioned in lines 1 and 2 above were in conformance with regulations and rules therefore as required in the current manual of survey instructions of the United States Department of the Interior, Bureau of Land Management or by a decree of a Court of Law and/or that the corner points mentioned in lines 3, 4 and 5 above were in conformance with the rules of the Michigan Board of Land Surveyors or by a Decree of a Court of Law; established, re-established, monumented, recovered, found as expressed below:

NOTE: Not more than 2 corners, all in the same town and range, may be recorded on this certificate.

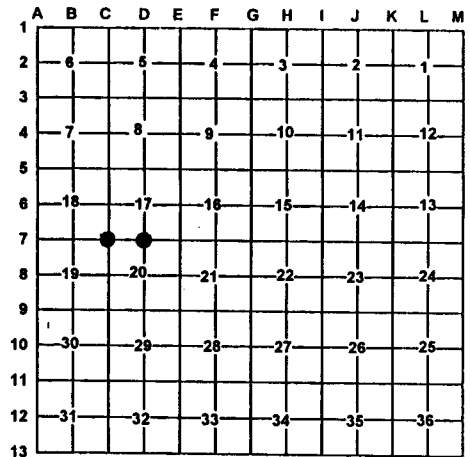

A. Description of original monument and accessories and/or subsequent restoration:

C-7 G.L.O. - B.F. Hall D.S. May 18, 1846
Set post corner sections 17, 18, 19, and 20.
Wit: Black Ash 18" S76°E 47 links
Black Ash 12" N05°E 21 links

D-7 G.L.O. B.F. Hall D.S. May 18, 1846
A Hemlock 12" in Diameter for quarter section post.
No Witnesses given.

George Henning R.L.S. # 2240 - 1940 map of section 18 shows railroad iron for corner, no witnesses.

B. Description of corner evidence found and/or method applies in restoring or re-establishing corner:

C-7 Found 1/2" iron rod over a railroad rail 18" below grade.

D-7 Found 3/4" rerod with P.S. cap # 43048 as set by Joseph G. Curtis.

C. Description of monument for corner and accessories established to perpetuate locating the position of the corner:

C-7 Set 5/8" X 20" rerod with P.S. cap #33981 in monument box over railroad rail.

D-7 3/4" rerod with P.S. cap #43048

Wit: 8" Scotch pine N56°E 46.51'
8" White pine S79°E 41.31'
6" Apple S54°W 57.33'
Rail Road tie fence corner post N38°W 46.56'

Wit: 16" Tamarack West 27.41'
10" White Birch N23°W 37.51'
4" Spruce N42°E 44.32'
22" Twin Maple N83°E 15.87'

Signed by: _____

Carl T. Kiiskila

Date: _____

4/4/00

Surveyor's Michigan License No.: 33981

