

LAND CORNER RECORDATION CERTIFICATE

Filing Requirement of Act 74, Mich. PA 1970

For Corners In: Ogemaw (County)	Located In	Corner Code #	
1. Public Land Survey	T 21N R 2E	E-5	
	T 21N R 2E	D-5	
2. Property Controlling in Section	S _____ T _____ R _____		
	S _____ T _____ R _____		
3. Miscellaneous Property in Section	S _____ T _____ R _____		
	S _____ T _____ R _____		


4. Lot No: _____ Recorded Plat: _____

5. Private Claims: _____

I, Carl T. Kiiskila, in a field survey on February, 2000 do hereby state that under requirements of PA 74, Michigan PA of 1970, the corner points mentioned in lines 1 and 2 above were in conformance with regulations and rules therefore as required in the current manual of survey instructions of the United States Department of the Interior, Bureau of Land Management or by a decree of a Court of Law and/or that the corner points mentioned in lines 3, 4 and 5 above were in conformance with the rules of the Michigan Board of Land Surveyors or by a Decree of a Court of Law; established, re-established, monumented, recovered, found as expressed below:

NOTE: Not more than 2 corners, all in the same town and range, may be recorded on this certificate.

Register of Deeds Stamp & File Number

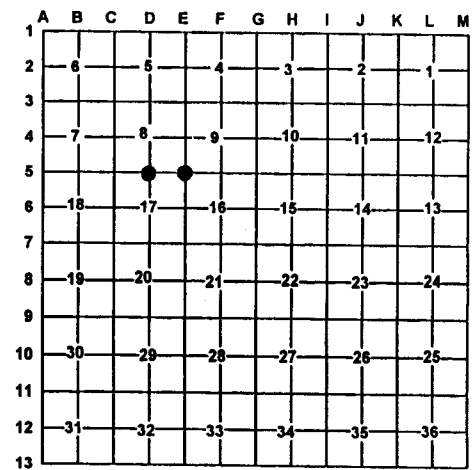

A. Description of original monument and accessories and/or subsequent restoration:

E-5 G.L.O. B.F. Hall D.S. – May 15, 1846
 Set post corner sections 8, 9, 16, and 17
 Wit: Hemlock 10" N30°E 23 links
 Hemlock 8" S62°W 8 links
Norman C. Caldwell RLS# 12018 -Oct.1965
 Liber 1, Page 99. Found large cabin spike in position as shown on records surveys by R. Ostling RLS and J. Richardson, R.L.S. placed 2" pipe at spike
 Wit: S50°E 51.50' 12" Maple
 S43°W 42.90' 10" Ash
 N67°E 84.23' 7" Maple
 S65°E 77.33' 8" Maple
Harlan Page #13591 M.D.O.T.- Jan 1970, Liber 1, Page 94
 Found 2" iron pipe
 Wit: N67°E 84.23' 7" Maple
 S65°E 77.33' 8" Maple
 N80°E 64.10' 9" Maple

D-5 G.L.O. B.F. Hall D.S. – May 18, 1846
 Set quarter section post
 Wit: Beech 12" S74°E 12 links
 Hemlock 8" S12°W 6 links
Norman C. Caldwell RLS# 12018 -Oct.14,1965
 Liber 1, Page 98. Found white pointed stone and Pine knot in centerline of East-West road. Corner is 2' East of fences North and South.
 Wit: N07°W 27.25' Corner fence post
 N47°W 40.31' Gate post
 N50°W 108.85' Power pole
 S53°W 114.63' Power pole

B. Description of corner evidence found and/or method applies in restoring or re-establishing corner:

E-5 Found 2" iron pipe below 1/2" iron rod with P.S. cap # 27595 D-5 Found 1/2" iron rod

C. Description of monument for corner and accessories established to perpetuate locating the position of the corner:

<p>E-5 1/2" iron rod with P.S. cap #27595</p> <p>Wit: 5" White Birch N16°E 53.16' 12" Ash N43°E 51.84' 8" Cedar S66°E 59.67' Angle iron corner post S85°E 37.51' East edge of concrete I-75 West 69± Carsonite post North 1±</p>	<p>D-5 1/2" iron rod</p> <p>Wit: 16" Swamp Willow S66°E 75.01' Power pole S57°W 114.38' Power pole N41°W 108.99' 6" Spruce N51°E 120.35'</p>
--	--

Signed by: Carl T. Kiiskila
 Surveyor's Michigan License No.: 33981

Date: 4/4/00

