

FEB 24 2000

Ogemaw County Remonumentation
LAND CORNER RECORDATION CERTIFICATE
Filing Requirement of Act 74, Mich. P.A. 1970

SECTION

For corners in

Ogemaw
(County)

Located In:

Corner Code #



3007254

Page: 1 of 1
01/14/2000 11:28A
L-4 P-39

Manda Muzik, Ogemaw Co. Registrar SURC 9.00

- 1. Public Land Survey T21N R02E A-9
- T R
- T R
- T R
- 2. Property Controlling in Section S T R
- S T R
- 3. Miscellaneous S T R
- Property in Sec. S T R

Sec. 2

Register of Deeds Stamp & File Number

- 4. Lot No. _____, Recorded Plat _____
- 5. Private Claims _____

I, Timothy L Lapham, in a field survey on January, 19 00 do hereby state that under requirements of P.A. 74, Michigan P.A. of 1970, the corner points mention in lines 1 and 2 above were in conformance with regulations and rules therefore as required in the current manual of survey instructions of the United States Department of the Interior, Bureau of Land Management or by a decree of a Court of Law and/or that the corner points mentioned in lines 3, 4 and 5 above were in conformance with the rules of the Michigan Board of Land Surveyors or by a Decree of a Court of Law; established, re-established, monumented, recovered, found as expressed below:

NOTE: Not more than 2 corners, all in the same town and range, may be recorded on this certificate

1	A	B	C	D	E	F	G	H	I	J	K	L	M
2	6	5	4	3	2	1							
3													
4	7	8	9	10	11	12							
5													
6	18	17	16	15	14	13							
7													
8	19	20	21	22	23	24							
9													
10	30	29	28	27	26	25							
11													
12	31	32	33	34	35	36							
13													

A. Description of original monument and accessories and/or subsequent restoration:

- A-9: GLO by Clason, 1838, Post
 - S43W 7 6" Cedar
 - N67W 8 10" Cedar
- DNR Survey by Roser, 1995, Fd spike
Accepted spike
- LCRC by Lapham, 1995, Set iron
 - N58E 69.77 Power Pole
 - S58W 34.72 Tole Pedestal
 - S82W 74.18 10" Ash
 - N32W 78.35 10" Poplar
- Road Plans, 1999
Distance to B-9 (T21N, R2E) 2848.79

Approved by Peer Review


12/16/99 JLR
DATE INITIALS

B. Description of corner evidence found and/or method applied in restoring or reestablishing corner:

A-9: No GLO evidence found. No corner or witnesses from 1995 remon corner found. Reset corner from distance North and South, road plans distance East and previous section work distance West. Accepted reestablished corner as best evidence of correct corner position.

C. Description of monument for corner and accessories established to perpetuate locating the position of the corner:

- A-9: Set 5/8"x36" rerod w/aluminum remon cap
 - N52E 59.58 Utility Pole
 - S50E 85.04 8" Poplar
 - S65W 74.38 10" Elm
 - N34W 91.95 4" Birch

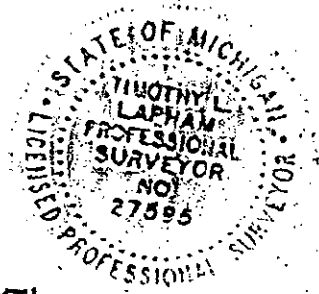

Signed by *Timothy L. Lapham*
Surveyor's Michigan License No. 27595

Date 1/14/2000