

**SURVEY & REMONUMENTATION**

**MAR 19 1998**

**OGEMAW COUNTY REMONUMENTATION**

**SECTION**

**LAND CORNER RECORDATION CERTIFICATE**  
Filing Requirement of Act 74, Mich. P.A. 1970

For corners in

<u>Ogemaw</u> (County)	Located In:	Corner Code #
1. Public Land Survey	T 21N R 2E	M-1
	T 22N R 2E	M-13
	T 21N R 3E	A-1
	T 22N R 3E	A-13
2. Property Controlling in Section	S T R	
3. Miscellaneous Property in Sec.	S T R	

**LIBER 3 PAGE 124**  
STATE OF MICHIGAN  
OGEMAW COUNTY  
RECORDED  
26 Dec 1997 2:49:53 PM  
WANDA MUZIK  
REGISTER OF DEEDS

Register of Deeds Stamp & File Number

4. Lot No. \_\_\_\_\_, Recorded Plat \_\_\_\_\_  
5. Private Claims \_\_\_\_\_

I, Timothy L. Lapham, in a field survey on November 20 19 97 do hereby state that under requirements of P.A. 74, Michigan P.A. of 1970, the corner points mentioned in lines 1 and 2 above were in conformance with regulations and rules therefore as required in the current manual of survey instructions of the United States Department of the Interior, Bureau of Land Management or by a decree of a Court of Law and/or that the corner points mentioned in lines 3, 4 and 5 above were in conformance with the rules of the Michigan Board of Land Surveyors or by a Decree of a Court of Law, established, re-established, monumented, recovered, found as expressed below:

NOTE: Not more than 2 corners, all in the same town and range, may be recorded on this certificate.

A	B	C	D	E	F	G	H	I	J	K
1										
2	6		5		4		3		2	
3										
4	7		8		9		10		11	
5										
6	18		17		16		15		14	
7										
8	19		20		21		22		23	
9										
10	30		29		28		27		26	
11										
12	31		32		33		34		35	
13										

**A. Description of original monument and accessories and/or subsequent restoration:**

GLO 1838 L. Clason set post  
Sp. pine 10" S19W 36 Lk  
Sp. pine 10" N56E 100 Lk

MDOT not dated, Fd axle shaft  
47.56 ft. sta 415+93.00  
S30E 58.18 4" black oak  
N70E 63.71 4" black oak

J. Richardson not dated, replaced per  
MSHD plans, 1/2" bar  
12" Oak N15E 87.02  
10" Oak S32 1/2E 58.14 (state)  
10" Oak N67E 63.47 (state)  
12" Oak N39E 57.94

LCRC 1-315, T. Lapham, 12/1984, found  
3/4" steel rod  
N15E 87.02 12" Oak  
S30E 58.00 12" Oak  
N45E 58.09 12" Oak  
N80E 56.67 14" Oak  
S80E 32.83 10" Oak  
West 47.34 P.K. nail centerline M-33

(CONTINUED ON BACK)

**B. Description of corner evidence found and/or method applied in restoring or reestablishing corner:**

Found railroad spike in 1" pipe. Material does not match any records. No evidence of GLO Remains.  
MDOT, found SE wit and stump of NE wit.  
C.P. Co., found SE wit, NE wit gone, ROW marker gone.  
Richardson, found 3 wits and stump (NOTE).  
Lapham, found 5 wits, PK gone.  
Ledy, found 2 wits, NW wit found N40E, NWN wit found N72E  
All records indicate same position for corner with no history back to GLO.

Approved by Peer Review


11-20-97 DATE *JLR* INITIALS

Accepted found iron as best evidence of corner position.

**C. Description of monument for corner and accessories established to perpetuate locating the position of the corner:**

Set 5/8"x36" rerod with 3-1/4" Aluminum Ogemaw Remon cap marked "27595 1997" in 1" Pipe  
S30E 58.00 MDOT tag in 14" Oak  
S74E 32.85 MDOT tag in 8" Trip. Oak  
N72E 56.74 MDOT tag in 16" Oak  
N40E 58.01 MDOT tag in 12" Oak  
N18E 87.03 Spike in 14" Doub. Oak  
West 48.4 Centerline pavement M-33

Signed by *Timothy L. Lapham*  
Surveyor's Michigan License No. 27595

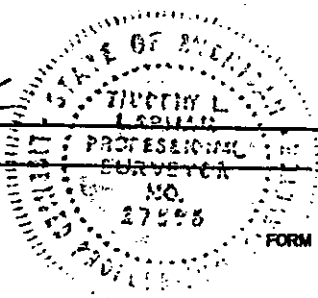

Date 12/24/97

Survey (4-360.72) D. Ledy 2/1990  
Fd. 3/4" rod 48.2 E. of centerline M-33  
SE 57.98 10" Oak  
S85E 32.96 8" Tri. Oak  
NW 57.96 8" Oak  
WNW 56.69 12" Oak

Consumers Power Survey undated  
1/2" iron pin  
Highway ROW marker East 27.57  
8" Oak NE 57.96  
8" Oak SE 58.20