

**SURVEY &
REMONUMENTATION**

JUN 02 1994

COMMISSION

For corners in

OGEMAW COUNTY REMONUMENTATION

LAND CORNER RECORDATION CERTIFICATE
Filing Requirement of Act 74, Mich. P.A. 1970

RECORDED
OGEMAW COUNTY, MI.

LIBER 2 PAGE 229

93 DEC 29 PM 3:00

Wanda Mizik
REGISTER OF DEEDS
OGEMAW COUNTY

Register of Deeds Stamp & File Number

OGEMAW (County)	Located In:	Corner Code #
1. Public Land Survey	T <u>21N</u> R <u>3E</u>	<u>M-2</u>
	T _____ R _____	_____
	T _____ R _____	_____
	T _____ R _____	_____
2. Property Controlling in Section	S _____ T _____ R _____	_____
	S _____ T _____ R _____	_____
3. Miscellaneous Property in Sec.	S _____ T _____ R _____	_____
	S _____ T _____ R _____	_____

4. Lot No. _____, Recorded Plat _____
5. Private Claims _____

	A	B	C	D	E	F	G	H	I	J	K	L
2	6		5		4		3		2			
3												
4	7		8		9		10		11		12	
5												
6	13		17		16		15		14		13	
7												
8	19		20		21		22		23		24	
9												
10	30		29		28		27		26		25	
11												
12	31		32		33		34		35		36	
13												

I, TIMOTHY L. LAPHAM, in a field survey on December, 1993, do hereby certify that under requirements of P.A. 74, Michigan P.A. of 1970, the corner points mentioned in lines 1 and 2 above were in conformance with regulations and rules therefore as required in the current manual of survey instructions of the United States Department of the Interior, Bureau of Land Management or by a decree of a Court of Law and/or that the corner points mentioned in lines 3, 4 and 5 above were in conformance with the rules of the Michigan Board of Land Surveyors or by a Decree of a Court of Law; established, re-established, monumented, re-monumented, recovered, found as expressed below:

NOTE: Not more than 4 corners, all in the same town and range, may be recorded on this certificate.

A. Description of original monument and accessories and/or subsequent restoration:


M-2: 1837, CLASON, POST, IN EDGE OF POND; TAMARACK 10" N40W 2.46 CHNS; 1/6/1975, K.OSTLING, SURVEY, REFERENCE CORNER-N. EDGE OF LAKE; 1943, G.SHADKO, SURVEY, REFERENCE CORNER;

B. Description of corner evidence found and/or method applied in restoring or reestablishing corner:

M-2: FOUND MICHIGAN CONSERVATION DEPARTMENT PUBLIC FISHING SITE, 4" BRASS CAP OCTOGON CONCRETE MONUMENT IN WATER AT SHORE LINE LAKE. SET AS REFERENCE CORNER TO 1/4 CORNER 36.1' SOUTH OF MONUMENT.
ACCEPTED MONUMENT AS REFERENCE CORNER TO BEST EVIDENCE OF LOCATION OF ORIGINAL CORNER. THIS CORNER ESTABLISHED IN OGEMAW COUNTY REMONUMENTATION PROGRAM. SEE DOSSIER FOR DETAILED REPORT.

C. Description of monument for corner and accessories established to perpetuate locating the position of the corner:

M-2: NO MONUMENT SET AT CORNER. REFERENCE CORNER 36.1 FEET NORTH ALONG SECTION LINE WAS FOUR REFERENCE CORNER WITNESSES:
MICHIGAN CONSERVATION DEPARTMENT PUBLIC FISHING, 4" BRASS CAP OCTOGON CONCRETE MONUMENT.
AZ 180° 7'±/- N SHORE LONG LAKE (VEGETATION LINE) IN 1/2' WATER±/-
AZ 236° 36.55' SPIKE NORTH FACE 8" DEAD ASH
AZ 186° 3.86' SPIKE WEST FACE 16" DEAD STUB
AZ 315° 81.23' SPIKE SW FACE 6" JACK PINE
AZ 0° 94.13' SPIKE WEST FACE 21" WEEPING WILLOW

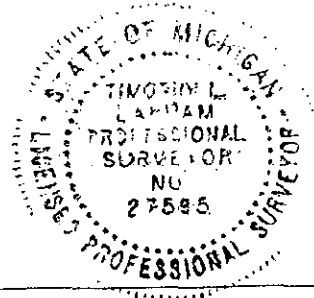

Signed by *[Signature]*

Date 12/28/93

Surveyor's Michigan License No. 27595