

**SURVEY &
(REMONUMENTATION)**

JUN 0 2 1994

COMMISSION

OGEMAW COUNTY REMONUMENTATION

**LAND CORNER RECORDATION CERTIFICATE
Filing Requirement of Act 74, Mich. P.A. 1970**

RECORDED
OGEMAW COUNTY, MICH.
LIBER 2 PAGE 231

93 DEC 29 PM 3:04

Wanda Trzask
REGISTER OF DEEDS
OGEMAW COUNTY

Register of Deeds Stamp & File Number

For corners in

OGEMAW (County)	Located In:	Corner Code #
1. Public Land Survey	T 21N R 3E	M-4
	T R	
	T R	
	T R	
2. Property Controlling in Section	S T R	
	S T R	
3. Miscellaneous Property in Sec.	S T R	
	S T R	

4. Lot No. _____, Recorded Plat _____
5. Private Claims _____

TIMOTHY L. LAPHAM, in a field survey on November, 19 93, do hereby certify that under requirements of P.A. 74, Michigan P.A. of 1970, the corner points mentioned in lines 1 and 2 above were in conformance with regulations and rules therefore as required in the current manual of survey instructions of the United States Department of the Interior, Bureau of Land Management or by a decree of a Court of Law and/or that the corner points mentioned in lines 3, 4 and 5 above were in conformance with the rules of the Michigan Board of Land Surveyors or by a Decree of a Court of Law; established, re-established, monumented, re-monumented, recovered, found as expressed below:

NOTE: Not more than 4 corners, all in the same town and range, may be recorded on this certificate.

A. Description of original monument and accessories and/or subsequent restoration:

M-4: 1838 L. CLASON; POST; TAMARACK 4" S76W 13 LK; TAMARACK 5" N54W 14 LK
2/26/1974 N. CALDWELL; LCRC 1-56; FOUND STEEL BAR AND WITNESSES
11/16/1977 EDMANDS ENG.; SURVEY 2-456; DUPLICATE OF ABOVE


B. Description of corner evidence found and/or method applied in restoring or reestablishing corner:

M-4: FOUND 1" STEEL BAR
FOUND RECORD WITNESSES
S45W 13.1' 10" TAMARACK SCRIBED NBT
N48E 10.3' 10" TAMARACK SCRIBED NBT
THIS CORNER ESTABLISHED IN OGEMAW COUNTY REMONUMENTATION PROGRAM.
SEE DOSSIER FOR DETAILED REPORT.

C. Description of monument for corner and accessories established to perpetuate locating the position of the corner:

M-4: SET 5/8"X36" REROD WITH 3" OGEMAW COUNTY MONUMENT CAP
AZ 310° 10.60' SPIKE IN SW FACE 10" DEAD TAMARACK SCRIBED NBT
AZ 209° 13.25' SPIKE IN SE FACE 10" DEAD TAMARACK SCRIBED NBT
AZ 270° 0.65' 1" ROD IN PIPE 5' +/- LONG
AZ 97° 28.37' SPIKE IN S FACE OF 6" TAMARACK
AZ 90° 300' +/- CENTERLINE OF ROAD

	A	B	C	D	E	F	G	H	I	J	K	L	M
2	6	5	4	3	2	1							
3													
4	7	8	9	10	11	12							
5													
6	18	17	16	15	14	13							
7													
8	19	20	21	22	23	24							
9													
10	30	29	28	27	26	25							
11													
12	31	32	33	34	35	36							

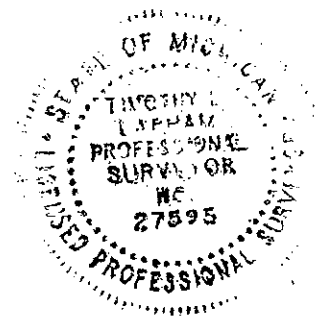

Signed by *[Signature]*

Date 12/28/93

Surveyor's Michigan License No. 27595