

SURVEY & REMONUMENTATION

JUN 02 1994

COMMISSION

OGEMAW COUNTY REMONUMENTATION

LAND CORNER RECORDATION CERTIFICATE
Filing Requirement of Act 74, Mich. P.A. 1970

RECORDED
 OGEMAW COUNTY, MI
 LIBER 2 PAGE 232

93 DEC 29 PM 3:04

Wanda Tuzik
 REGISTER OF DEEDS
 OGEMAW COUNTY

For corners in

OGEMAW (County)	Located in:	Corner Code #
1. Public Land Survey	T <u>21N</u> R <u>3E</u>	<u>M-5</u>
	T _____ R _____	_____
	T _____ R _____	_____
	T _____ R _____	_____
2. Property Controlling in Section	S _____ T _____ R _____	_____
	S _____ T _____ R _____	_____
3. Miscellaneous Property in Sec.	S _____ T _____ R _____	_____
	S _____ T _____ R _____	_____

Register of Deeds Stamp & File Number

4. Lot No. _____, Recorded Plat _____
 5. Private Claims _____

	A	B	C	D	E	F	G	H	I	J	K	L	M
2	6		5		4		3		2		1		
3													
4	7		8		9		10		11		12		
5													
6	18		17		16		15		14		13		
7													
8	19		20		21		22		23		24		
9													
10	30		29		28		27		26		25		
11													
12	31		32		33		34		35		36		
13													

I, TIMOTHY L. LAPHAM, in a field survey on November, 1993, do hereby certify that under requirements of P.A. 74, Michigan P.A. of 1970, the corner points mentioned in lines 1 and 2 above were in conformance with regulations and rules therefore as required in the current manual of survey instructions of the United States Department of the Interior, Bureau of Land Management or by a decree of a Court of Law and/or that the corner points mentioned in lines 3, 4 and 5 above were in conformance with the rules of the Michigan Board of Land Surveyors or by a Decree of a Court of Law; established, re-established, monumented, re-monumented, recovered, found as expressed below:

NOTE: Not more than 4 corners, all in the same town and range, may be recorded on this certificate.

A. Description of original monument and accessories and/or subsequent restoration:


M-5: 1838 L. CLASON; POST; Y. PINE 15" S50W 18 LK; Y. PINE 18" N58W 31 LK
 8/5/1971 EDMANDS ENG.; SURVEY 1-31; NO WITNESSES
 2/26/1974 N. CALDWELL; LCRC 1-56; 1/2" BAR AND WITNESSES
 7/30/1974 EDMANDS ENG.; SURVEY 1-444; NO WITNESSES
 9/18/1974 EDMANDS ENG.; SURVEY 1-491; WITH WITNESSES
 6/7/1976 EDMANDS ENG.; SURVEY 2-132; DUPLICATE PREV. WITNESSES
 11/16/77 EDMANDS ENG.; SURVEY 2-456; DUPLICATE PREV, WITNESSES

B. Description of corner evidence found and/or method applied in restoring or reestablishing corner:

M-5: FOUND NAIL OVER 1/2"X18" REROD OVER 1/2" REROD 3'+/- DEEP
 FOUND WITNESSES:
 2/26/1974; N48°E 71.16' CORNER OF CONCRETE WINDOW WELL
 9/18/1974; SW 58.63" P.P.
 NE 75.25' TO HOUSE CORNER AT BLOCKS
 THIS CORNER ESTABLISHED IN OGEMAW COUNTY REMONUMENTATION PROGRAM.
 SEE DOSSIER FOR DETAILED REPORT.

C. Description of monument for corner and accessories established to perpetuate locating the position of the corner:

M-5: SET 5/8"X36" REROD WITH 3" OGEMAW CO. MONUMENT CAP IN MON. BOX
 AZ 133° 47.79' SPIKE IN NW FACE CORNER FENCE POST
 AZ 45° 75.13 SW CORNER OF BLOCK 2 STORY BUILDING
 AZ 46° 71.09' SW CORNER OF WINDOW WELL
 AZ 310° 55.68' SPIKE IN NE FACE UTILITY POLE

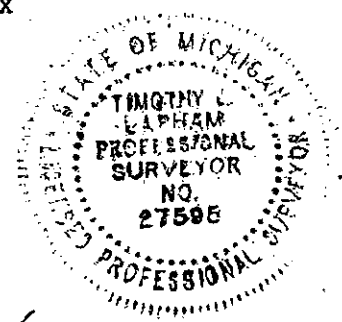

Signed by *[Signature]*
 Surveyor's Michigan License No. 27595

Date 12/28/93