

**SURVEY & REMONUMENTATION**

JUN 02 1994

**OGEMAW COUNTY REMONUMENTATION**

**LAND CORNER RECORDATION CERTIFICATE**  
Filing Requirement of Act 74, Mich. P.A. 1970

RECORDED  
OGEMAW COUNTY, MICH.  
LIBER 2 PAGE 234

93 DEC 29 PM 3:05

*Wanda Juzik*  
REGISTER OF DEEDS  
OGEMAW COUNTY

Register of Deeds Stamp & File Number

For corners in **COMMISSION**

OGEMAW (County)	Located In:	Corner Code #
1. Public Land Survey	T <u>21N</u> R <u>3E</u>	<u>M-9</u>
	T _____ R _____	_____
	T _____ R _____	_____
	T _____ R _____	_____
2. Property Controlling in Section	S _____ T _____ R _____	_____
	S _____ T _____ R _____	_____
3. Miscellaneous Property in Sec.	S _____ T _____ R _____	_____
	S _____ T _____ R _____	_____

4. Lot No. \_\_\_\_\_, Recorded Plat \_\_\_\_\_  
5. Private Claims \_\_\_\_\_

	A	B	C	D	E	F	G	H	I	J	K	L	I
2	6	5	4	3	2	1							
3													
4	7	8	9	10	11	12							
5													
6	18	17	16	15	14	13							
7													
8	19	20	21	22	23	24							
9													
10	30	29	28	27	26	25							
11													
12	31	32	33	34	35	36							
13													

I, **TIMOTHY L. LAPHAM**, in a field survey on December, 19 93, do hereby certify that under requirements of P.A. 74, Michigan P.A. of 1970, the corner points mentioned in lines 1 and 2 above were in conformance with regulations and rules therefore as required in the current manual of survey instructions of the United States Department of the Interior, Bureau of Land Management or by a decree of a Court of Law and/or that the corner points mentioned in lines 3, 4 and 5 above were in conformance with the rules of the Michigan Board of Land Surveyors or by a Decree of a Court of Law, established, re-established, monumented, re-monumented, recovered, found as expressed below.

**NOTE: Not more than 4 corners, all in the same town and range, may be recorded on this certificate.**

**A. Description of original monument and accessories and/or subsequent restoration:**

M-9: 1838, CLASON, POST, BEECH 12" S72W 17L, BEECH 10" N45W 32L;  
3/28/1972, N. CALDWELL, LCRC 1-16 & (132) 1-73 COR IN LAKE, 3 REFERENCE CORNERS  
8/17/1989, D. LEDY, (132) 4-383, CORNER IN LAKE, USED REF COR SOUTH  
6/4/1990, T. LAPHAM, (132) NOT REC, IN LAKE, REF COR S AND E  
7/27/1992, T. LAPHAM, (132) NOT REC, IN LAKE


**B. Description of corner evidence found and/or method applied in restoring or reestablishing corner:**

M-9: NO GLO CORNER OR WITNESSES, CORNER FALLS IN LAKE.  
FOUND REFERENCE CORNERS N AND S OF LAKE, ACCEPTED REFERENCE CORNER POSITION AS BEST EVIDENCE OF ORIGINAL POSITION OF THE CORNER.

THIS CORNER ESTABLISHED IN THE OGEMAW COUNTY REMONUMENTATION PROGRAM.  
SEE DOSSIER FOR DETAILED REPORT.

**C. Description of monument for corner and accessories established to perpetuate locating the position of the corner:**

M-9: CORNER FALLS IN LAKE. REFERENCE CORNER 200.00' SOUTH OF LAKE ON TOWNSHIP LINE.  
AZ 0° 83'+/- SHORELINE OF LAKE  
AZ 202° 82.23' NE CORNER OF FOUNDATION OF SHED ADDITION TO HOUSE  
AZ 183° 78.47' SPIKE IN W FACE OF 12" POPLAR  
AZ 18° 0.55' CENTER OF STEEL 'T' TYPE FENCE POST  
AZ 148° 97.56' SPIKE IN SW FACE OF 8" TRIPLE ASH

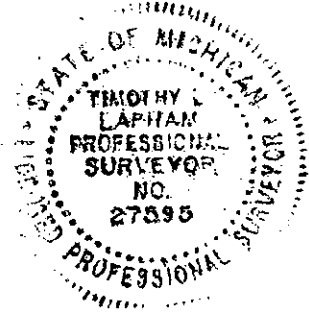

Signed by *[Signature]*

Date 12/28/93

Surveyor's Michigan License No. 27595