

SURVEY & REMONUMENTATION

JUN 02 1994

COMMISSION

OGEMAW COUNTY REMONUMENTATION

LAND CORNER RECORDATION CERTIFICATE
Filing Requirement of Act 74, Mich. P.A. 1970

For corners in

OGEMAW (County)	Located In:	Corner Code #
1. Public Land Survey	T <u>21N</u> R <u>3E</u>	<u>M-10</u>
	T _____ R _____	_____
	T _____ R _____	_____
	T _____ R _____	_____
2. Property Controlling in Section	S _____ T _____ R _____	_____
	S _____ T _____ R _____	_____
3. Miscellaneous Property in Sec.	S _____ T _____ R _____	_____
	S _____ T _____ R _____	_____

RECORDED
 Ogemaw County, Mi.
 LIBER 2 PAGE 235

93 DEC 29 PM 3:05

Wanda Muzik
 REGISTER OF DEEDS
 OGEMAW COUNTY

Register of Deeds Stamp & File Number

4. Lot No. _____, Recorded Plat _____
 5. Private Claims _____

	A	B	C	D	E	F	G	H	I	J	K	L	M
2	6		5		4		3		2		1		
3													
4	7		8		9		10		11		12		
5													
6	18		17		16		15		14		13		
7													
8	19		20		21		22		23		24		
9													
10	30		29		28		27		26		25		
11													
12	31		32		33		34		35		36		
13													

I, TIMOTHY L. LAPHAM, in a field survey on November, 1993, do hereby certify that under requirements of P.A. 74, Michigan P.A. of 1970, the corner points mentioned in lines 1 and 2 above were in conformance with regulations and rules therefore as required in the current manual of survey instructions of the United States Department of the Interior, Bureau of Land Management or by a decree of a Court of Law and/or that the corner points mentioned in lines 3, 4 and 5 above were in conformance with the rules of the Michigan Board of Land Surveyors or by a Decree of a Court of Law, established, re-established, monumented, re-monumented, recovered, found as expressed below:

NOTE: Not more than 4 corners, all in the same town and range, may be recorded on this certificate.

A. Description of original monument and accessories and/or subsequent restoration:


M-10: 1838 L. CLASON; POST; BEECH 12" S72W 17 LKS; BEECH 10" N45W 32 LKS
 1/4/1960 H. CECIL HOOK; KNOTT SUBDIVISION; PLATS 3-46
 6/28/1968 N. CALDWELL; SURVEY NO CORNER INFORMATION
 1/29/1970 N. CALDWELL; SURVEY REFERENCED TO KNOTT SUBD.; NO WITNESSES
 7/12/1973 L. CAVANAGH; FOUND IRON
 6/4/1990 T. LAPHAM; FOUND RAILROAD SPIKE
 7/27/1992 T. LAPHAM; LCRC 2-190
 7/27/1992 T. LAPHAM; FD. R/R SPIKE AND WITNESSES PER LCRC 2-190

B. Description of corner evidence found and/or method applied in restoring or reestablishing corner:

M-10: FOUND RAILROAD SPIKE OVER NAIL OVER 1/2"X36" REROD OVER 1/2" REROD 2.5' +/- DEEP, CORNER IN CORRECT RELATIONSHIP TO KNOTT SUBD., 11/29/1970 SURVEY, AND 7/27/1992 LCRC AND SURVEY;
 FOUND WITNESSES:
 S44°W 52.71' POWER POLE
 N35°E 88.33' 20" W. OAK
 S88°E 38.93' 2" ELM
 THIS CORNER ESTABLISHED IN OGEMAW COUNTY REMONUMENTATION PROGRAM.
 SEE DOSSIER FOR DETAILED REPORT.

C. Description of monument for corner and accessories established to perpetuate locating the position of the corner:

M-10: SET 5/8"X36" REROD WITH 3" OGEMAW CO. MONUMENT CAP IN MON. BOX OVER 3' +/- DEEP 1/2" REROD
 AZ 227° 52.67' SPIKE IN NW FACE LIGHT POLE
 AZ 90° 38.92' SPIKE IN N FACE 3" ELM
 AZ 34° 88.32' SPIKE IN SE FACE 22" OAK
 AZ 309° 140.39' S. CORNER OF WHITE BRICK FACE ON BLOCK BUILDING

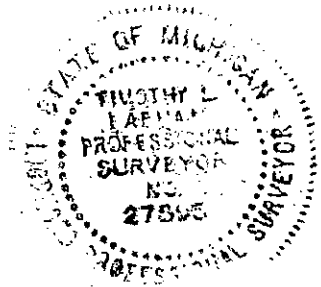

Signed by *Timothy L. Lapham* Date 12/28/93
 Surveyor's Michigan License No. 27595