

SURVEY & REMONUMENTATION

JUN 02 1994

COMMISSION

OGEMAW COUNTY REMONUMENTATION

LAND CORNER RECORDATION CERTIFICATE
Filing Requirement of Act 74, Mich. P.A. 1970

RECORDED
 Ogemaw County, Mich.
 LIBER 2 PAGE 238

93 DEC 29 PM 3:06

Wanda Mizik
 REGISTER OF DEEDS
 OGEMAW COUNTY

Register of Deeds Stamp & File Number

For corners in

OGEMAW (County)	Located In:	Corner Code #
1. Public Land Survey	T <u>21N</u> R <u>3E</u>	<u>M-13</u>
	T _____ R _____	_____
	T _____ R _____	_____
	T _____ R _____	_____
2. Property Controlling in Section	S _____ T _____ R _____	_____
	S _____ T _____ R _____	_____
3. Miscellaneous Property in Sec.	S _____ T _____ R _____	_____
	S _____ T _____ R _____	_____

4. Lot No. _____, Recorded Plat _____
 5. Private Claims _____

TIMOTHY L. LAPHAM, in a field survey on November, 1993, do hereby certify that under requirements of P.A. 74, Michigan P.A. of 1970, the corner points mentioned in lines 1 and 2 above were in conformance with regulations and rules therefore as required in the current manual of survey instructions of the United States Department of the Interior, Bureau of Land Management or by a decree of a Court of Law and/or that the corner points mentioned in lines 3, 4 and 5 above were in conformance with the rules of the Michigan Board of Land Surveyors or by a Decree of a Court of Law; established, re-established, monumented, re-monumented, recovered, found as expressed below:

NOTE: Not more than 4 corners, all in the same town and range, may be recorded on this certificate.

	A	B	C	D	E	F	G	H	I	J	K	L	P
2	6		5		4		3		2		1		
3													
4	7		8		9		10		11		12		
5													
6	18		17		16		15		14		13		
7													
8	19		20		21		22		23		24		
9													
10	30		29		28		27		26		25		
11													
12	31		32		33		34		35		36		
13													

A. Description of original monument and accessories and/or subsequent restoration:


M-13: 1838 L.CLASON; POST; Y. PINE 20" N15W 45LK; HEMLOCK 24" N40E 32LK
 1985+/- R. MILLER; SURVEY, REFERENCED CORNER
 9/4/1990 LAPHAM; SURVEY REFERENCED CORNER, USED MILLER CORNER

B. Description of corner evidence found and/or method applied in restoring or reestablishing corner:

M-13: FOUND 1/2"X18" P.S. CAPPED IRON #16050 IN APPROXIMATE CENTERLINE OF OLD EAST-WEST ROADBED; CORNER IS IN APPROXIMATE CORRECT POSITION TO STREAM WEST OF CORNER PER GLO; MILLER AND LAPHAM BOTH USED THIS CORNER FOR THE SURVEYS IN DOSSIER ACCEPTED FOUND CORNER AS BEST EVIDENCE OF ORIGINAL CORNER POSITION. THIS CORNER ESTABLISHED IN OGEMAW COUNTY REMONUMENTATION PROGRAM. SEE DOSSIER FOR DETAILED REPORT.

C. Description of monument for corner and accessories established to perpetuate locating the position of the corner:

M-13: SET 5/8"X36" REROD WITH 3" OGEMAW COUNTY MONUMENT CAP
 AZ 129° 24.57' SPIKE IN N FACE 7" TWIN MAPLE, BLAZED
 AZ 16° 3.89' SPIKE IN E FACE 5" BIRCH, BLAZED
 AZ 298° 13.08' SPIKE IN N FACE 4" BIRCH, BLAZED
 AZ 248° 25.51' SPIKE IN N FACE 5" MAPLE IN CLUMP, BLAZED
 AZ 246° 25.59' SPIKE IN S FACE 8" MAPLE IN CLUMP
 AZ 270° 260'+/- CENERLINE OF STREAM BED AT OLD ROAD BED

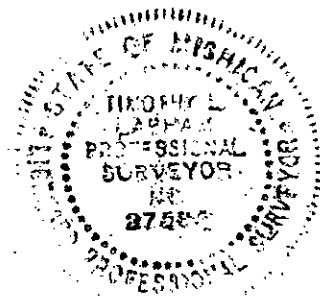

Signed by *[Signature]*

Date 12/28/93

Surveyor's Michigan License No. 27595