

MAY 28 1997

OGEMAW COUNTY REMONUMENTATION

COMMISSION

LAND CORNER RECORDATION CERTIFICATE
Filing Requirement of Act 74, Mich. P.A. 1970

For corners in

Ogemaw (County)	Located In:	Corner Code #
1. Public Land Survey	T 21N R 4E	B - 1
	T R	
	T R	
	T R	
2. Property Controlling in Section	S T R	
	S T R	
3. Miscellaneous Property in Sec.	S T R	
	S T R	

STATE OF MICHIGAN
OGEMAW COUNTY
RECORDED

30 DEC 96 4:33 P.M.

WANDA MUZIK
REGISTER OF DEEDS
Register of Deeds Stamp & File Number

4. Lot No. _____, Recorded Plat _____
5. Private Claims _____

I, Timothy L. Lapham, in a field survey on December, 19 96 do hereby state that under requirements of P.A. 74, Michigan P.A. of 1970, the corner points mentioned in lines 1 and 2 above were in conformance with regulations and rules therefore as required in the current manual of survey instructions of the United States Department of the Interior, Bureau of Land Management or by a decree of a Court of Law and /or that the corner points mentioned in lines 3, 4 and 5 above were in conformance with the rules of the Michigan Board of Land Surveyors or by a Decree of a Court of Law; established, re-established, monumented, recovered, found as expressed below:

NOTE: Not more than 2 corners, all in the same town and range, may be recorded on this certificate.

A	B	C	D	E	F	G	H	I	J	K	L	M
1												
2	6	5	4	3	2	1						
3												
4	7	8	9	10	11	12						
5												
6	18	17	16	15	14	13						
7												
8	19	20	21	22	23	24						
9												
10	30	29	28	27	26	25						
11												
12	31	32	33	34	35	36						
13												

A. Description of original monument and accessories and/or subsequent restoration:

- Not set by GLO N13-17-56W 119.67' Concrete Monument
- Survey Henning 9/51
- 1-1/4"X5' pipe
- 24" Pine N08E 46.0'
- 5" Ash S54E 9.0'
- Survey, Henning 11/65
- Same as Above
- Survey, Henning 6/67
- No corner material or witnesses
- Survey, Higgins 10/12/84 (Rec L3, P507)
- Found 2-1/2"X5' pipe


B. Description of corner evidence found and/or method applied in restoring or reestablishing corner:

No corner set in GLO survey. Position established at pro-rated distance between A-1 and C-1 on line between A-1 and meander corner on East side of Hardwood Lake. See dossier for additional information.

APPROVED BY
PEER REVIEW
12-18-96 TL
DATE P.A. 345 of 1990

C. Description of monument for corner and accessories established to perpetuate locating the position of the corner:

Corner falls in Lake. Not set.

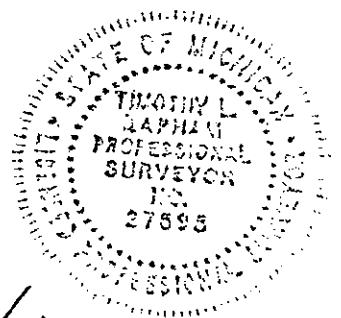

Signed by [Signature]
Surveyor's Michigan License No. 27595

Date 12/27/96