

SURVEY &
REMONUMENTATION

MAY 28 1997

OGEMAW COUNTY REMONUMENTATION

LIBER 3 PAGE 101

COMMISSION

LAND CORNER RECORDATION CERTIFICATE
Filing Requirement of Act 74, Mich. P.A. 1970

For corners in

Ogemaw (County)	Located in:	Corner Code #
1. Public Land Survey	T 21N R 4E	D - 1
	T R	
	T R	
	T R	
2. Property Controlling in Section	S T R	
	S T R	
3. Miscellaneous Property in Sec.	S T R	
	S T R	

STATE OF MICHIGAN
OGEMAW COUNTY
RECORDED
30 DEC 96 4:33 P.M.
WANDA MUZIK
REGISTER OF DEEDS
Register of Deeds Stamp & File Number

4. Lot No. _____, Recorded Plat _____
5. Private Claims _____

I, Timothy L. Lapham, in a field survey on December, 19 96, do hereby state that under requirements of P.A. 74, Michigan P.A. of 1970, the corner points mentioned in lines 1 and 2 above were in conformance with regulations and rules therefore as required in the current manual of survey instructions of the United States Department of the Interior, Bureau of Land Management or by a decree of a Court of Law and/or that the corner points mentioned in lines 3, 4 and 5 above were in conformance with the rules of the Michigan Board of Land Surveyors or by a Decree of a Court of Law; established, re-established, monumented, recovered, found as expressed below:

NOTE: Not more than 2 corners, all in the same town and range, may be recorded on this certificate.

	A	B	C	D	E	F	G	H	I	J	K	L	M
1													
2		6		5		4		3		2		1	
3													
4		7		8		9		10		11		12	
5													
6		18		17		16		15		14		13	
7													
8		19		20		21		22		23		24	
9													
10		30		29		28		27		26		25	
11													
12		31		32		33		34		35		36	
13													

A. Description of original monument and accessories and/or subsequent restoration:

Not set by GLO
No subsequent survey information available


B. Description of corner evidence found and/or method applied in restoring or reestablishing corner:

No existing corner found. Set monument GLO proportionate distance between C-1 and E-1 and on line between C-13 and D13 T22N R4E.

APPROVED BY
PEER REVIEW
12-18-96 JW
DATE P.A. 345 of 1990

C. Description of monument for corner and accessories established to perpetuate locating the position of the corner:

Set 5/8" X 38" re-rod with 2-1/4" Aluminum cap Marked "1996 27595"
From Which:
N01E 70.85' Utility Pole
S83E 40.03' 5/8" Capped rered D-13 T22N R4E
South 33.03' Fence Post
N62W 69.85' Fence Post
South 2' Centerline road

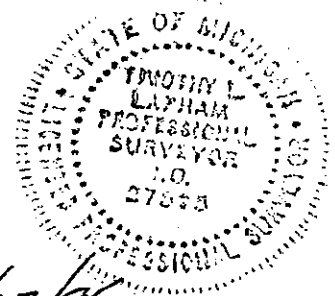

Signed by [Signature]
Surveyor's Michigan License No. 27595

Date 12/27/96