

SURVEY &
REMONUMENTATION

OGEMAW COUNTY REMONUMENTATION

LIBER 111 3 PAGE 102

MAY 28 1997

LAND CORNER RECORDATION CERTIFICATE
Filing Requirement of Act 74, Mich. P.A. 1970

COMMISSION

For corners in

Ogemaw (County)	Located In:	Corner Code #
1. Public Land Survey	T 21N R 4E	E - 1
	T R	
	T R	
	T R	
2. Property Controlling in Section	S T R	
	S T R	
3. Miscellaneous Property in Sec.	S T R	
	S T R	

STATE OF MICHIGAN
OGEMAW COUNTY
RECORDED

30 DEC 96 4:33 P.M.

WANDA MUZIK
REGISTER OF DEEDS

Register of Deeds Stamp & File Number

4. Lot No. _____, Recorded Plat _____
5. Private Claims _____

	A	B	C	D	E	F	G	H	I	J	K	L	P
1													
2	6			5		4		3		2		1	
3													
4	7			8		9		10		11		12	
5													
6	18			17		16		15		14		13	
7													
8	19			20		21		22		23		24	
9													
10	30			29		28		27		26		25	
11													
12	31			32		33		34		35		36	
13													

I, Timothy L. Lapham, in a field survey on December, 19 96 do hereby state that under requirements of P.A. 74, Michigan P.A. of 1970, the corner points mentioned in lines 1 and 2 above were in conformance with regulations and rules therefore as required in the current manual of survey instructions of the United States Department of the Interior, Bureau of Land Management or by a decree of a Court of Law and/or that the corner points mentioned in lines 3, 4 and 5 above were in conformance with the rules of the Michigan Board of Land Surveyors or by a Decree of a Court of Law; established, re-established, monumented, recovered, found as expressed below.


NOTE: Not more than 2 corners, all in the same town and range, may be recorded on this certificate.

A. Description of original monument and accessories and/or subsequent restoration:

GLO B.F. Hall 1848
Set Post 54 links west of E13 T22N R4E
Maple 10" S15E 28 links
W. Pine 18" S35W 30 links
1987 Lapham, Section break of Section 4 T21N R4E
Found 1/2" pipe at GLO distance west of E13, T22N R4E
R4E
No witnesses

B. Description of corner evidence found and/or method applied in restoring or reestablishing corner:

No evidence of GLO corner found. Found 1/2" iron pipe in centerline of road East-West. Distance to E-13 T22N R4E matches GLO and 1987 Lapham section Break. Accepted found corner as best evidence of the position of the Original Corner.

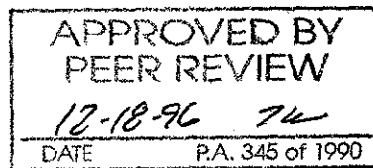

C. Description of monument for corner and accessories established to perpetuate locating the position of the corner:

Set 5/8" X38" re-rod with 2-1/4" Aluminum cap Marked "1896 27595"
From Which:
N58E 79.60' Fence post
S88E 37.50' 5/8" capped rerod E-13 T22N R4E
S27E 27.71' Fence Corner Post
S59W 53.43' Fence post
East 33' Centerline Beach road



Signed by [Signature]
Surveyor's Michigan License No. 27578

Date 12/27/96