

MAY 28 1997

LAND CORNER RECORDATION CERTIFICATE
Filing Requirement of Act 74, Mich. P.A. 1970

COMMISSION

For corners in

Ogemaw

(County)

Located In:

Corner Code #

1. Public Land Survey

T	21N	R	4E	G - 1
T		R		
T		R		
T		R		
T		R		

2. Property Controlling in Section

S	T	R
S	T	R
S	T	R
S	T	R

3. Miscellaneous Property in Sec.

4. Lot No. _____, Recorded Plat _____
5. Private Claims _____

STATE OF MICHIGAN
OGEWAW COUNTY
RECORDED

30 DEC 96 4:34 P.M.

WANDA MUZIK
REGISTER OF DEEDS

Register of Deeds Stamp & File Number

I, Timothy L. Lapham, in a field survey on December, 19 96 do hereby state that under requirements of P.A. 74, Michigan P.A. of 1970, the corner points mentioned in lines 1 and 2 above were in conformance with regulations and rules therefore as required in the current manual of survey instructions of the United States Department of the Interior, Bureau of Land Management or by a decree of a Court of Law and /or that the corner points mentioned in lines 3, 4 and 5 above were in conformance with the rules of the Michigan Board of Land Surveyors or by a Decree of a Court of Law; established, re-established, monumented, recovered, found as expressed below:

NOTE: Not more than 2 corners, all in the same town and range, may be recorded on this certificate.

	A	B	C	D	E	F	G	H	I	J	K	L	M
1													
2	6		5		4		3		2		1		
3													
4	7		8		9		10		11		12		
5													
6	18		17		16		15		14		13		
7													
8	19		20		21		22		23		24		
9													
10	30		29		28		27		26		25		
11													
12	31		32		33		34		35		36		
13													

A. Description of original monument and accessories and/or subsequent restoration:
GLO, B.F. Hall, 1846 North 3' Extension of Fence East

- Set Post
- Cedar 10" S60-1/2W 15 links
- Birch 12" S10E 37 links
- 1987, Lapham, Section Break of Section 4 T21N R4E
- 1/2" rerod set at GLO distance from G-13 T22N R4E, East 30.38' from S.E. corner Section 33, T22N R4E
- East 87.27' Fence Corner Post
- North 47.80' Power Pole
- North 1' Centerline Road


B. Description of corner evidence found and/or method applied in restoring or reestablishing corner:

No evidence of GLO corner found. Found 1/2" iron in centerline of road East-West at GLO distance West from G-13 T22N R4E. Remains of old fence Due South. Accepted found corner as best available evidence of the position of the original corner. See dossier for additional information.

APPROVED BY
PEER REVIEW
12-18-96 *TL*
DATE P.A. 345 of 1990

C. Description of monument for corner and accessories established to perpetuate locating the position of the corner:

- Set 5/8"X3/8" re-rod with 2-1/4" Aluminum cap Marked "1996 27595"
- From Which:
- S89E 87.38' Fence Corner Post
- S41E 89.21' Fence Post
- East 30.38' 5/8" capped rerod G-13 T22N R4E
- N03E 47.36' Utility Pole

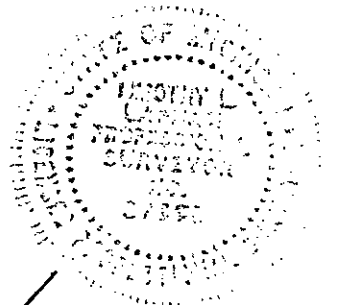

Signed by *Timothy L. Lapham*
Surveyor's Michigan License No. 27595

Date 12/27/96