

SURVEY &
REMONUMENTATION

SEP 28 1998

LAND CORNER RECORDATION CERTIFICATE
Filing Requirement of Act 74, Mich. P.A. 1970

For corners in SECTION

Ogemaw
(County)

Located In:

Corner Code #

- 1. Public Land Survey T 22N R 1E
T 23N R 1E
T _____ R _____
T _____ R _____
- 2. Property Controlling in Section S _____ T _____ R _____
S _____ T _____ R _____
- 3. Miscellaneous Property in Sec. S _____ T _____ R _____
S _____ T _____ R _____

A-1 ✓
A-13

LIBER 3 PAGE 170

STATE OF MICHIGAN
OGEMAW COUNTY
RECORDED

7/14/1998 9:26:45 AM

WANDA NUZIK
REGISTER OF DEEDS

Register of Deeds Stamp & File Number

- 4. Lot No. _____, Recorded Plat _____
- 5. Private Claims _____

I, Marvin E. Myers, in a field survey on 4-29, 1998 do hereby state that under requirements of P.A. 74, Michigan P.A. of 1970, the corner points mentioned in lines 1 and 2 above were in conformance with regulations and rules therefore as required in the current manual of survey instructions of the United States Department of the Interior, Bureau of Land Management or by a decree of a Court of Law and /or that the corner points mentioned in lines 3, 4 and 5 above were in conformance with the rules of the Michigan Board of Land Surveyors or by a Decree of a Court of Law, established, re-established, monumented, recovered, found as expressed below:

	A	B	C	D	E	F	G	H	I	J	K	L	M
1													
2	6		5		4		3		2		1		
3													
4	7		8		9		10		11		12		
5													
6	18		17		16		15		14		13		
7													
8	19		20		21		22		23		24		
9													
10	30		29		28		27		26		25		
11													
12	31		32		33		34		35		36		
13													

NOTE: Not more than 2 corners, all in the same town and range, may be recorded on this certificate.

A. Description of original monument and accessories and/or subsequent restoration:

GLO - 1838 L. Clason, D.S. L.1, Pg. 290 Oct 26, 1982 K.J. Ostling, P.S. #10068
Mon. - Post Found 1 1/4" Pipe with concrete base, by M. Schaaf
14" Y. Pine N42°E 49 lks in line with firelines N. & W. and fence S.
16" Y. Pine S22°E 181 lks 12" Red Oak N37°E 18.8'
7" Black Oak N30°W 28.4'
Fence Corner S10°E 2.5'

B. Description of corner evidence found and/or method applied in restoring or reestablishing corner:

Found 1/2" iron in centerline fence intersection to the South and East. Found GLO. witnesses; Y. Pine stump N42°E 32.3', and Y. pine stump S22°E 119.4'. Iron matches GLO witnesses.


Found nail with Roscommon tag in the NW. side of a 16" R. Oak N30°E 19.51'
Found nail with Roscommon tag in the NW. side of a 8" B. Oak N36°W 28.58'
Found nail with Roscommon tag in the NW. side of a 10" W. Oak S58°W 51.90'
Found nail with Roscommon tag in the NW. side of a 10" S40°E 45.62'
Found GLO Y. Pine stump N42°E 32.3'
Found GLO Y. Pine stump S22°E 119.4'

Accepted as a perpetuation of the Original Government Corner. Replaced 1/2" iron with Standard County Monument.

C. Description of monument for corner and accessories established to perpetuate locating the position of the corner:

Mon.- Standard Roscommon County Monument.
Wit: Found nail with Roscommon tag in the NW. side of a 16" R. Oak N30°E 19.51'
Found nail with Roscommon tag in the NW. side of a 8" B. Oak N36°W 28.58'
Found nail with Roscommon tag in the NW. side of a 10" W. Oak S58°W 51.90'
Found nail with Roscommon tag in the NW. side of a 10" S40°E 45.62'

Signed by Marvin E. Myers
Surveyor's Michigan License No. 31600

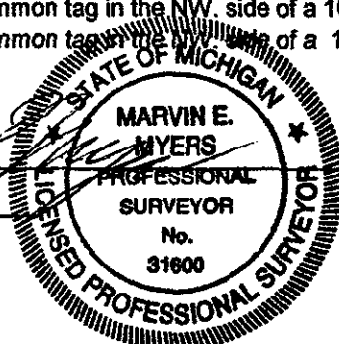

Date July 9, 1998

Approved by Peer Review
6/2/1998
JITALS
EAS