

SURVEY &
REMONUMENTATION

SEP 28 1998

LAND CORNER RECORDATION CERTIFICATE
Filing Requirement of Act 74, Mich. P.A. 1970

For corners in SECTION

LIBER 3 PAGE 172

STATE OF MICHIGAN
OGEMAW COUNTY
RECORDED

Ogemaw
(County)

Located In:

Corner Code #

- | | | |
|---------------------------------------|--------------------------|------------|
| 1. Public Land Survey | T <u>22N</u> R <u>1E</u> | <u>A-3</u> |
| | T _____ R _____ | _____ |
| | T _____ R _____ | _____ |
| | T _____ R _____ | _____ |
| 2. Property Controlling
in Section | S _____ T _____ R _____ | _____ |
| | S _____ T _____ R _____ | _____ |
| 3. Miscellaneous
Property in Sec. | S _____ T _____ R _____ | _____ |
| | S _____ T _____ R _____ | _____ |

7/14/1998 9:26:45 AM

WANDA MUZIK
REGISTER OF DEEDS

Register of Deeds Stamp & File Number

4. Lot No. _____, Recorded Plat _____
5. Private Claims _____

I, Marvin E. Myers, in a field survey on 4-23, 1998, do hereby state that under requirements of P.A. 74, Michigan P.A. of 1970, the corner points mentioned in lines 1 and 2 above were in conformance with regulations and rules therefore as required in the current manual of survey instructions of the United States Department of the Interior, Bureau of Land Management or by a decree of a Court of Law and/or that the corner points mentioned in lines 3, 4 and 5 above were in conformance with the rules of the Michigan Board of Land Surveyors or by a Decree of a Court of Law; established, re-established, monumented, recovered, found as expressed below:

1	A	B	C	D	E	F	G	H	I	J	K	L	M
2		6		5		4		3		2		1	
3													
4		7		6		9		10		11		12	
5													
6		18		17		16		15		14		13	
7													
8		19		20		21		22		23		24	
9													
10		30		29		28		27		26		25	
11													
12		31		32		33		34		35		36	
13													

NOTE: Not more than 2 corners, all in the same town and range, may be recorded on this certificate.

A. Description of original monument and accessories and/or subsequent restoration:

- A-3 GLO - 1838 Lewis Clason, D.S.
Mon. - Post
13" White Oak S69°W 48 lks.
16" Y. Pine N23°W 109 lks.
GLO - 1846 B.F. Hall, D.S.
Mon - Post
Wit: 18" Y. Pine N83°E 17 lks
18" Y. Pine S46°E 81 lks
L. 6, Pg. 147 (Timothy, L. Lapham, P.S. #27595 Nov. 23, 1988)
Mon. - 1 1/2" pipe in concrete in N-S fence line, and Firelane West.
Nails & Tags in:
10" R. Pine N50°W 38.05'
12" R. Pine S25°W 110.47'
12" Oak S75°E 43.08'

Approved by Peer Review

6/2/1998 WJ
DATE INITIALS


B. Description of corner evidence found and/or method applied in restoring or reestablishing corner:

Found 1 1/2" pipe with cap (Paul B. Lapham, P.S. #9433), 0.8' East of North-South fence, and Centerline of trail to the West.
Found nail in the NW. side of a 16" Red Pine (placed new nail directly above) S20°W 110.54'. Found nail and Lapham tag in the NE. side of a 12" Red Pine N60°W 38.11'. Found nail in the SW. side of a 12" dead Oak S73°E 43.10'. Accepted as best available evidence of the position of the Original Government Corner.

C. Description of monument for corner and accessories established to perpetuate locating the position of the corner:

- Mon.- Standard Roscommon County Monument.
Wit: Found nail in the NW. side of a 16" Red Pine (placed new nail directly above) S20°W 110.54'
Found nail and Lapham tag in the NE. side of a 12" Red Pine N60°W 38.11'
Found nail in the SW. side of a 12" dead Oak S73°E 43.10'
Set nail in the SW. side of a 18" Oak S40°E 59.48'
Set nail in the SE. side of a 4" Red Pine N31°E 46.29'

Signed by Marvin E. Myers
Surveyor's Michigan License No. 31600

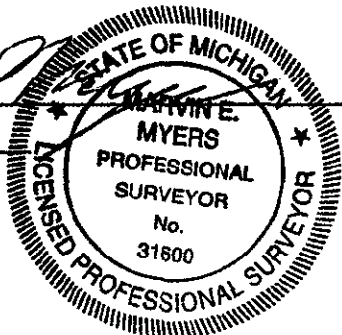

Date June 4, 1998