

SURVEY &
REMONUMENTATION

SEP 28 1998

LAND CORNER RECORDATION CERTIFICATE
Filing Requirement of Act 74, Mich. P.A. 1970

For corners in SECTION

Ogemaw
(County)

Located In:

Corner Code #

- 1. Public Land Survey T 22N R 1E
- T _____ R _____
- T _____ R _____
- T _____ R _____
- 2. Property Controlling S _____ T _____ R _____
- in Section S _____ T _____ R _____
- 3. Miscellaneous S _____ T _____ R _____
- Property in Sec. S _____ T _____ R _____

A-4

LIBER 3 PAGE 173
STATE OF MICHIGAN
OGEMAW COUNTY
RECORDED

7/14/1998 9:26:45 AM

WANDA MUZIK
REGISTER OF DEEDS

Register of Deeds Stamp & File Number

- 4. Lot No. _____, Recorded Plat _____
- 5. Private Claims _____

I, Marvin E. Myers, in a field survey on 4-23, 1998, do hereby state that under requirements of P.A. 74, Michigan P.A. of 1970, the corner points mentioned in lines 1 and 2 above were in conformance with regulations and rules therefore as required in the current manual of survey instructions of the United States Department of the Interior, Bureau of Land Management or by a decree of a Court of Law and /or that the corner points mentioned in lines 3, 4 and 5 above were in conformance with the rules of the Michigan Board of Land Surveyors or by a Decree of a Court of Law; established, re-established, monumented, recovered, found as expressed below:

1	A	B	C	D	E	F	G	H	I	J	K	L	M
2		6		5		4		3		2		1	
3													
4		7		8		9		10		11		12	
5													
6		18		17		16		15		14		13	
7													
8		19		20		21		22		23		24	
9													
10		30		29		28		27		26		25	
11													
12		31		32		33		34		35		36	
13													

NOTE: Not more than 2 corners, all in the same town and range, may be recorded on this certificate.

A. Description of original monument and accessories and/or subsequent restoration:

- A-4 GLO - 1838 Lewis Clason, D.S.
Mon. - Post
14" Y. Pine S55°W 80 lks.
16" Y. Pine N60°W 61 lks.
- L. 1, Pg. 114 (Norman C. Caldwell, P.S. # 12018 4-18-1966)
Mon. - 1 1/4" Pipe in conc. Raised with 1/2" bar.
In N-S fence line. Found original Gov. Bearing trees
18" Pine Stump S55°W 53.48'
15" Pine Stump N60°W 41.12'
12" Oak N60°W 42.73'
6" Oak S65°E 31.71'
- L. 2, Pg. 155
Mon. - 1/2" bar
18" Pine Stump S55°W 53.48'
15" Pine Stump N60°W 41.12'
12" Oak N60°W 42.73'
6" Oak S65°E 31.71'
- L. 6, Pg. 147 (Timothy, L. Lapham, P.S. #27595 Nov. 23, 1988)
Mon. - Found 1/2" Rod in Fence
Spike in Fence Post South 3.70'
10" Oak S20°E 38.45'
12" Oak N20°E 48.15'

B. Description of corner evidence found and/or method applied in restoring or reestablishing corner:


Found 1/2" iron over 1 1/4" Pipe in concrete (typical Schaaf Monument) in North-South fence and in center of old North-South road corridor. Accepted as a perpetuation of the Original Government Corner. Replaced 1/2" bar with Standard County Monument.

C. Description of monument for corner and accessories established to perpetuate locating the position of the corner:

- Mon. - Standard Roscommon County Monument.
- Set nail in the E. side of the Southerly 6" twin Red Pine N49°W 38.18'
- Set nail in the SE. side of a 20" Oak N35°E 48.06'
- Set nail in a 18" Oak S29°E 38.51'
- Set nail in the S. side 4" Oak S86°E 25.80'

Approved by Peer Review
6/2/1998 JM
DATE INITIALS

Signed by Marvin E. Myers
Surveyor's Michigan License No. 31600

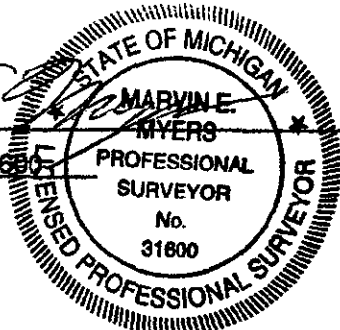

Date Jan 4th 1998