

**SURVEY &  
REMONUMENTATION**

SEP 28 1998

**LAND CORNER RECORDATION CERTIFICATE  
Filing Requirement of Act 74, Mich. P.A. 1970**

For corners in SECTION

Ogemaw  
(County)

Located In:

Corner Code #

1. Public Land Survey	T <u>22N</u> R <u>1E</u>	<u>A-8</u>
	T _____ R _____	_____
	T _____ R _____	_____
	T _____ R _____	_____
2. Property Controlling in Section	S _____ T _____ R _____	_____
	S _____ T _____ R _____	_____
3. Miscellaneous Property in Sec.	S _____ T _____ R _____	_____
	S _____ T _____ R _____	_____

LIBER **3** PAGE **177**  
STATE OF MICHIGAN  
OGEMAW COUNTY  
RECORDED  
7/14/1998 9:26:45 AM  
WANDA MUZIK  
REGISTER OF DEEDS

Register of Deeds Stamp & File Number

4. Lot No. \_\_\_\_\_, Recorded Plat \_\_\_\_\_  
5. Private Claims \_\_\_\_\_

I, Marvin E. Myers, in a field survey on 3-26, 1998, do hereby state that under requirements of P.A. 74, Michigan P.A. of 1970, the corner points mentioned in lines 1 and 2 above were in conformance with regulations and rules therefore as required in the current manual of survey instructions of the United States Department of the Interior, Bureau of Land Management or by a decree of a Court of Law and /or that the corner points mentioned in lines 3, 4 and 5 above were in conformance with the rules of the Michigan Board of Land Surveyors or by a Decree of a Court of Law, established, re-established, monumented, recovered, found as expressed below.

**NOTE: Not more than 2 corners, all in the same town and range, may be recorded on this certificate.**

1	A	B	C	D	E	F	G	H	I	J	K	L	M
2		6		5		4		3		2		1	
3													
4		7		8		9		10		11		12	
5													
6		18		17		16		15		14		13	
7													
8		19		20		21		22		23		24	
9													
10		30		29		28		27		26		25	
11													
12		31		32		33		34		35		36	
13													

**A. Description of original monument and accessories and/or subsequent restoration:**

<b>A-8</b>	<b>GLO - 1837 John Brink, D.S.</b> Mon. - Post 16" Yellow Pine N45°W 125 lks. 16" Yellow Pine S13°W 52 lks.	<b>L. 1, Pg. 35 (Larry L. Cavanagh)</b> P.S. #17614 April 3, 1973) Mon. - Found 1/2" bar 6" Maple S45°E 33.75' 7" Maple West 8.1' 6" W. Oak N25°E 51.7'
	<b>Schaaf (RLS) 1930±</b> Found, or established and replaced	
	<b>J. Richardson (RLS)</b> Mon.- Found one Gov. Bt. and two pits. Stain at corner well defined set 1/2"x36" iron & wood marker. 7" B. Oak S82°W 8.2' 7" W. Oak S61°E 33.7' 8" W. Oak N21°E 51.68'	<b>Robert L. Higgins (P.S. #21570) Nov. 10, 1978</b> <b>Timothy L. Lapham (27595) Apr. 15, 1997</b> Mon.- Found 1/2" bar 6" Maple S45°E 33.75' 7" Maple West 8.1' 6" W. Oak N25°E 51.7'

Approved by Peer Review  
6/2/1998 W  
DATE INITIALS


**B. Description of corner evidence found and/or method applied in restoring or reestablishing corner:**

Found 1/2" Iron of record. Witnesses of record have been destroyed. Found nail in the NE. side of a 12" Oak N33°W 18.58'  
Found nail in the W. side of a 4" Oak S19°W 14.44'. Found nail in the N. side of a 3" Maple S73°W 24.98'. Accepted as the best available evidence of the position of the Original Government Corner. Replaced 1/2" Iron with Standard County Monument.

**C. Description of monument for corner and accessories established to perpetuate locating the position of the corner:**

Mon.- Standard Roscommon County Monument.  
Found nail in the NE. side of a 12" Oak N33°W 18.58'  
Found nail in the W. side of a 4" Oak S19°W 14.44'  
Found nail in the N. side of a 3" Maple S73°W 24.98'  
Set nail in the E. side of a 8" Oak N04°E 49.94'

Signed by Marvin E. Myers  
Surveyor's Michigan License No. 31600

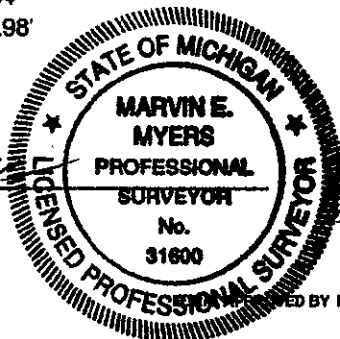

Date June 24 1998