

APR 08 1999

Ogemaw County Remonumentation

LAND CORNER RECORDATION CERTIFICATE  
Filing Requirement of Act 74, Mich. P.A. 1970

SECTION

For corners in

_____ Ogemaw _____ (County)	Located in:	Corner Code #
1. Public Land Survey	T22N R01E	G-9
	T _____ R _____	_____
	T _____ R _____	_____
	T _____ R _____	_____
2. Property Controlling in Section	S _____ T _____ R _____	_____
	S _____ T _____ R _____	_____
3. Miscellaneous Property in Sec.	S _____ T _____ R _____	_____
	S _____ T _____ R _____	_____

LIBER 3 PAGE 200

STATE OF MICHIGAN  
OGEMAW COUNTY  
RECORDED

23 DEC 1998 3:45:50 P

WANDA NUZIK  
REGISTER OF DEEDS

Register of Deeds Stamp & File Number

4. Lot No. \_\_\_\_\_, Recorded Plat \_\_\_\_\_  
5. Private Claims \_\_\_\_\_

I, Timothy L Lapham, in a field survey on December, 1998 do hereby state that under requirements of P.A. 74, Michigan P.A. of 1970, the corner points mention in lines 1 and 2 above were in conformance with regulations and rules therefore as required in the current manual of survey instructions of the United States Department of the Interior, Bureau of Land Management or by a decree of a Court of Law and/or that the corner points mentioned in lines 3, 4 and 5 above were in conformance with the rules of the Michigan Board of Land Surveyors or by a Decree of a Court of Law; established, re-established, monumented, recovered, found as expressed below:

1	A	B	C	D	E	F	G	H	I	J	K	L
2		6		5		4		3		2		1
3												
4		7		8		9		10		11		12
5												
6		18		17		16		15		14		13
7												
8		19		20		21		22		23		24
9												
10		30		29		28		27		26		25
11												
12		31		32		33		34		35		36
13												

**NOTE: Not more than 2 corners, all in the same town and range, may be recorded on this certificate**

A. Description of original monument and accessories and/or subsequent restoration:

- G-9:** GLO 6/21/1846 B.F. Hall set post  
Beech 12" S11W 11 lk  
Beech 8" N59W 21 lk  
LCRC 1-140 4/1966 N. Caldwell 3/4" bar in Mon. box  
North 100.00 R/W marker (1)  
S38W 190.61 NE Corner house (2)  
S11E 102.98 R/W marker (3)  
N47E 100.82 14" Oak (4)
- Survey 1-496 7/23/1974 L. McGinnis Mon Box centerline M-55  
SSE 48.45 NW corner headwall  
SW 66.0 R/W marker (5)  
SE 48.2 road sign
- Section break 7/1974 L. McGinnis - same as survey 1-496
- Survey 2/11/1976 R. Higgins pavement box, no witnesses
- LCRC 1-253 9/1980 R. Higgins 3/4" bar in mon. box - same as LCRC 1-140
- Co. road plans 1984 found mon. box - same as survey 1-496

B. Description of corner evidence found and/or method applied in restoring or reestablishing corner:


**G-9:** No evidence of GLO corner. Found 1/2" rerod with obliterated cap in centerline of roads E-W-S. Found witness (1), measured 99.65 to south face. Found witness (2), measured 189.98. Found witness (3) lying on ground at approximate record distance. Found witness (4), no spike, measured 100.51 to new spike. Found witness (5), measured 66.25 to NE corner. Accepted found rerod as best evidence of correct corner position.

C. Description of monument for corner and accessories established to perpetuate locating the position of the corner:

**G-9:** Set 5/8"x36" rerod with aluminum Ogemaw county remon. cap.  
Witnesses:  
N05W 99.65 S face of R/W marker  
N53E 100.51 new spike in SE face of 24" Oak  
S33W 66.25 NE corner of R/W marker  
S42W 189.98 NE corner of main part of brick house, note: not porch

Approved by Peer Review

12/15/1998 TL  
DATE INITIALS

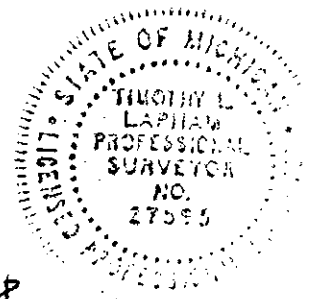

Signed by [Signature]  
Surveyor's Michigan License No. 27595

Date 12/23/98