

APR 08 1999

Ogemaw County Remonumentation

LAND CORNER RECORDATION CERTIFICATE
Filing Requirement of Act 74, Mich. P.A. 1970

SECTION

For corners in

<u>Ogemaw</u> (County)	Located in:	Corner Code #
1. Public Land Survey	T22N R01E	G-11
	T R	
	T R	
	T R	
2. Property Controlling in Section	S T R	
	S T R	
3. Miscellaneous Property in Sec.	S T R	
	S T R	

LIBER 3 PAGE 202
STATE OF MICHIGAN
OGEMAW COUNTY
RECORDED

23 DEC 1998 3:46:21 F

WANDA MUZIK
REGISTER OF DEEDS

Register of Deeds Stamp & File Number

4. Lot No. _____, Recorded Plat _____
5. Private Claims _____

I, Timothy L Lapham, in a field survey on December, 1998, do hereby state that under requirements of P.A. 74, Michigan P.A. of 1970, the corner points mention in lines 1 and 2 above were in conformance with regulations and rules therefore as required in the current manual of survey instructions of the United States Department of the Interior, Bureau of Land Management or by a decree of a Court of Law and/or that the corner points mentioned in lines 3, 4 and 5 above were in conformance with the rules of the Michigan Board of Land Surveyors or by a Decree of a Court of Law; established, re-established, monumented, recovered, found as expressed below:

	A	B	C	D	E	F	G	H	I	J	K	L
1												
2		6		5		4		3		2		1
3												
4		7		8		9		10		11		12
5												
6		18		17		16		15		14		13
7												
8		19		20		21		22		23		24
9												
10		30		29		28		27		26		25
11												
12		31		32		33		34		35		36
13												

NOTE: Not more than 2 corners, all in the same town and range, may be recorded on this certificate

A. Description of original monument and accessories and/or subsequent restoration:

G-11: GLO 6/21/1846 B.,F. Hall set post 1/2" bar West 33.0
W. Pine 30" N50W 231k. Spike in clump Maple N53W 58.21 (2)
W. Pine 24" N28E 22 1k. Spike in clump Maple N37E 84.45
24" R. Pine S43E 87.3 (3)

Survey L1P498 & L2P98 7/23/1974 L. McGinnis set 3/8" iron Co. Rd. plans 1997 J.P. May 1/2" iron bar 1' west of centerline
SE 47.35' Ref. iron N44E 120.34 12" trip. Beech (4)
W 26.05' fence corner S39E 86.85 26" R. Pine (5)
NW 57.00' face P.P. (1) S42W 80.25 12" W. Pine (6)
N26W 57.03 U.P. (7)

Section break 1974 L. McGinnis - same as survey 1-498
survey 2-100 3/26/1976 L. McGinnis - same as survey 1-498
LCRC 1-170 3/1977 L. McGinnis - same as survey 1-498
Co. Rd. plans 1984 corner not specified


B. Description of corner evidence found and/or method applied in restoring or reestablishing corner:

G-11: No evidence of GLO corner. Found 3/8" rerod 1' West of centerline. Found witness (1), measured 56.8+/- . Found cut off stump of witness (2) at record distance +/- . Found witness (3), no nail, measured 87.50 to new nail. Found witness (4), measured 120.16. Found witness (5), same as witness (3). Found witness (6), measured 80.20. Found witness (7), measured 57.05. Accepted found iron as best vailable evidence of correct corner position.

C. Description of monument for corner and accessories established to perpetuate locating the position of the corner:

G-11: Set 5/8"x36" rerod with aluminum Ogemaw county remon. cap. Witnesses:
N85W 34.09 spike in N face of new corner post
N24W 57.05 spike in NE face of power pole
N48W 59.58 new spike in NE face of NE tree in Maple clump
S37E 87.50 new spike in NE face of 26" R. Pine
S47W 80.20 spike in NW face of 10" W. Pine
N48E 120.16 spike in SE face of 12" trip. Beech

Approved by Peer _____
DATE 12/15/98

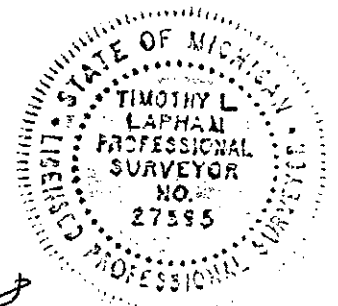

Signed by [Signature]
Surveyor's Michigan License No. 27595

Date 12/23/98