

LAND CORNER RECORDATION CERTIFICATE
Filing Requirement of Act 74, Mich. P.A. 1970

RF SURVEY & RECORDATION

FEB 24 2000

For corners in

Ogemaw
(County)

Located in:

Corner Code #

SECTION

1. Public Land Survey

T22N R01E

K-9

T R

T R

T R

2. Property Controlling In Section

S T R

S T R

3. Miscellaneous Property in Sec.

S T R

S T R

Barcode with number 3006778
Page: 1 of 1
12/27/1999 09:09A
L-3 P-287
Wanda Muzik, Ogemaw Co. Register SURC 9.00

Register of Deeds Stamp & File Number

4. Lot No. _____, Recorded Plat _____
5. Private Claims _____

I, Timothy L Lapham, in a field survey on December, 19 99 do hereby state that under requirements of P.A. 74, Michigan P.A. of 1970, the corner points mention in lines 1 and 2 above were in conformance with regulations and rules therefore as required in the current manual of survey instructions of the United States Department of the Interior, Bureau of Land Management or by a decree of a Court of Law and/or that the corner points mentioned in lines 3, 4 and 5 above were in conformance with the rules of the Michigan Board of Land Surveyors or by a Decree of a Court of Law; established, re-established, monumented, recovered, found as expressed below:

NOTE: Not more than 2 corners, all in the same town and range, may be recorded on this certificate

	A	B	C	D	E	F	G	H	I	J	K	L	M
1													
2	6		5		4		3		2		1		
3													
4	7		8		9		10		11		12		
5													
6	18		17		16		15		14		13		
7													
8	19		20		21		22		23		24		
9													
10	30		29		28		27		26		25		
11													
12	31		32		33		34		35		36		
13													

S48W 35.15 18" CSP (top center)

A. Description of original monument and accessories and/or subsequent restoration:

K-9: GLO by B.F. Hall, 1846, Post
S14W 48 8" Sugar
N23W 23 16" Sugar

Survey by D. Ledy, 1984, found 3/4" pipe in mon box
N25W 65.47 Power Pole
N34E 15.81 Bt spike in mon box

LCRC by F.J. King, 1986, found 1/2" iron in mon box
South 76.2 Centerline M-55
N25W 65.46 Power Pole
S40W 44.80 Stop Sign
S40E 46.40 Street Sign

Survey by F. King, 1987, found iron in mon box
South 76.2 Centerline M-55

LCRC by J.L. Wilcox, 1966, fd 1 1/2" axle shaft
N84E 15.81 Bt Spike in mon box
N25W 65.47 Power Pole
S41W 76.47 20" Maple
S32E 60.55 15" Maple

Survey by T. Lapham, 1997, found 1/2" iron in mon box
South 76.2 Centerline M-55
N25W 65.46 Power Pole
S40W 44.80 Stop Sign
S40E 46.40 Street Sign

Survey by L. Cavanagh, 1976, found 1/2" bar in pavement box
No witnesses

Survey by T. Lapham, 1995, found 1/2" iron in mon box
South 76.2 Centerline M-76
N20E 102.25 Right-of-way mon
N29W 64.10 Utility Pole

Approved by Peer Review


DATE 12-16-99 INITIALS JLK

B. Description of corner evidence found and/or method applied in restoring or reestablishing corner:

K-9: No GLO evidence found. Found 2 - 1968 witnesses, 2 - 1986 witnesses, and 3 - 1995 witnesses. Distance to K-8 matches all surveys of record. Found 1/2" iron bar in monument box. Accepted found iron as best evidence of correct corner position.

C. Description of monument for corner and accessories established to perpetuate locating the position of the corner:

K-8: Set 5/8"x36" rerod w/aluminum remon cap
N62E 186.07 SW Cor of Church
S75E 31.46 Cen of Manhole Cover
South 76.10 Centerline M-55
N72W 36.55 Utility Pole
N26W 64.68 Utility Pole

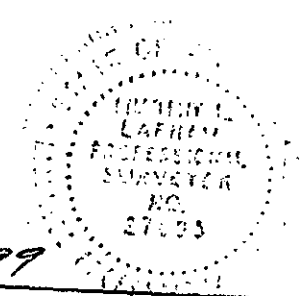

Signed by [Signature]
Surveyor's Michigan License No. 27595

Date 12/23/1999