

**SURVEY &
REMONUMENTATION**

MAY 28 1997

OGEMAW COUNTY REMONUMENTATION

EIBER 3 PAGE 69

COMMISSION

**LAND CORNER RECORDATION CERTIFICATE
Filing Requirement of Act 74, Mich. P.A. 1970**

STATE OF MICHIGAN
OGEMAW COUNTY
RECORDED

30 DEC 96 4:27 P.M.

WANDA MUZIK
REGISTER OF DEEDS

For corners in

Ogemaw (County)	Located In:	Corner Code #
1. Public Land Survey	T 22N R 1E	M-2 ✓
	T 22N R 2E	A-2
	T R	
	T R	
2. Property Controlling in Section	S T R	
	S T R	
3. Miscellaneous Property in Sec.	S T R	
	S T R	

Register of Deeds Stamp & File Number

4. Lot No. _____, Recorded Plat _____
5. Private Claims _____

I, Timothy L. Lapham, in a field survey on December, 19 96 do hereby state that under requirements of P.A. 74, Michigan P.A. of 1970, the corner points mentioned in lines 1 and 2 above were in conformance with regulations and rules therefore as required in the current manual of survey instructions of the United States Department of the Interior, Bureau of Land Management or by a decree of a Court of Law and /or that the corner points mentioned in lines 3, 4 and 5 above were in conformance with the rules of the Michigan Board of Land Surveyors or by a Decree of a Court of Law; established, re-established, monumented, recovered, found as expressed below:

NOTE: Not more than 2 corners, all in the same town and range, may be recorded on this certificate.

	A	B	C	D	E	F	G	H	I	J	K	L	M
1													
2		6		5		4		3		2		1	
3													
4		7		8		9		10		11		12	
5													
6		19		17		16		15		14		13	
7													
8		19		20		21		22		23		24	
9													
10		30		29		28		27		26		25	
11													
12		31		32		33		34		35		36	
13													

A. Description of original monument and accessories and/or subsequent restoration:

Note: Corner Common to A-2 T22N R2E
GLO L.Clason 1838
Set Post
B.Oak 4 S26W 27 links
W.Pine 5 N59W 1.31 ch
Survey, Richardson 8/74
No corner material or witnesses


B. Description of corner evidence found and/or method applied in restoring or reestablishing corner:

No evidence of GLO found. Found 5/8" Iron and three apparent witness trees, origin unknown. Distance North and south to M-1 and M-3 at approximately GLO proportion. Accepted found Iron as best evidence of the position of the original corner. See dossier for additional information.

APPROVED BY
PEER REVIEW
12-18-96 *TLL*
DATE P.A. 345 of 1990

C. Description of monument for corner and accessories established to perpetuate locating the position of the corner:

Set 5/8" X 36" rerod with 2-1/4" Aluminum cap marked "1996 27595"
From Which:
N68E 26.20' 8" W. Oak
S28E 22.99' 4" Poplar
S24W 48.24' 12" W. Pine
N70W 23.14' 15" W. Oak
Monument located 8' East of centerline trail North-South and 10' North of centerline trail East-West

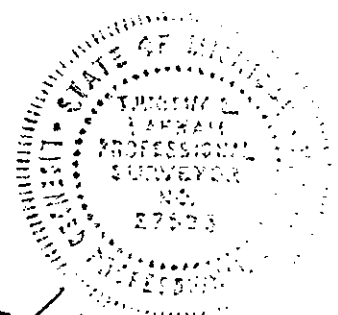

Signed by *Timothy L. Lapham*
Surveyor's Michigan License No. 27595

Date 12/27/96