

SURVEY & REMONUMENTATION

MAY 28 1997

OGEMAW COUNTY REMONUMENTATION

LIBER 12 3 PAGE 74

COMMISSION

LAND CORNER RECORDATION CERTIFICATE
Filing Requirement of Act 74, Mich. P.A. 1970

For corners in

<u>Ogemaw</u> (County)	Located In:	Corner Code #
1. Public Land Survey	T <u>22N</u> R <u>1E</u>	<u>M 7</u>
	T <u>22N</u> R <u>2E</u>	<u>A-7</u>
	T _____ R _____	_____
	T _____ R _____	_____
2. Property Controlling in Section	S _____ T _____	_____
	S _____ T _____	_____
3. Miscellaneous Property in Sec.	S _____ T _____	_____
	S _____ T _____	_____

STATE OF MICHIGAN
OGEMAW COUNTY
RECORDED
30 DEC 96 4:28 P.M.
WANDA MUZIK
REGISTER OF DEEDS
Register of Deeds Stamp & File Number

4. Lot No. _____, Recorded Plat _____
5. Private Claims _____

I, Timothy L. Lapham, in a field survey on December, 1996 do hereby state that under requirements of P.A. 74, Michigan P.A. of 1970, the corner points mentioned in lines 1 and 2 above were in conformance with regulations and rules therefore as required in the current manual of survey instructions of the United States Department of the Interior, Bureau of Land Management or by a decree of a Court of Law and /or that the corner points mentioned in lines 3, 4 and 5 above were in conformance with the rules of the Michigan Board of Land Surveyors or by a Decree of a Court of Law; established, re-established, monumented, recovered, found as expressed below:

NOTE: Not more than 2 corners, all in the same town and range, may be recorded on this certificate.

A	B	C	D	E	F	G	H	I	J	K	L	M
1												
2	6		5		4		3		2		1	
3												
4	7		8		9		10		11		12	
5												
6	18		17		16		15		14		13	
7												
8	19		20		21		22		23		24	
9												
10	30		29		28		27		26		25	
11												
12	31		32		33		34		35		36	
13												

A. Description of original monument and accessories and/or subsequent restoration:

Note: Corner Common to A-7 T22N R2E
GLO L.Clason 1838
Set post
Cedar 8 S61E 23 links
Tamarack 5" N08E 18 links
GLO B.F.Hall 1846
Found post, no wits
Survey Cavanagh, 11/71 (Rec L1, P35)
Found 7/8" Bar, 3 wits;
Survey, Higgins, 6/76 (Rec L2, P109)
Found 7/8" bar of record, no wits;
Survey, Higgins, 8/76 (Rec L2, P150)
Same as L2, P109
Survey, Higgins, 8/76 (Rec L2, P150)
Found 7/8" bar of record, no wits;
Survey, Higgins, 4/77 (Rec L2, P252)
Same as L2, P109
LCRC, Act 313, 9/77 (Rec L1, P182)
Found 7/8" bar of record
Survey Higgins, 9/78 (Rec L2, P531)
1/2" bar, 2 wits;
Survey, Ledy, 11/83 (Rec L3, P454)

1/2" bar, 2 wits;
LCRC, Lapham, 10/85 (Rec L1, P327)
Iron bar, 4 wits;
Survey, Lapham, 7/93 (Rec L5, P350-355)
Same as LCRC L1, P327


B. Description of corner evidence found and/or method applied in restoring or reestablishing corner:

No evidence of GLO corner found. Found 1/2" iron rod and three Lapham and one Cavanagh witnesses. Distance South to M-8 in accord with recorded surveys. Distance South to GLO topo Creek and Brook calls match GLO proportionate distance. Excess distance to North indicates the possibility that a tally was dropped during GLO survey. Accepted found corner as best evidence of the position of the original corner. See dossier for additional information.

APPROVED BY
PEER REVIEW
12-18-96 JL
DATE P.A. 345 of 1990

C. Description of monument for corner and accessories established to perpetuate locating the position of the corner:

Set 5/8"X36" rerod with 2-1/4" Aluminum cap marked "1996 27595"
In Monument Box
From Which:
N25E 108.42' Utility Pole
N84E 33.08' Capped Iron #21570
S58E 81.82' 4" Poplar
S22W 133.48' 8" Scotch Pine
Monument located 1.5' East of centerline Dow Road North-South and 20' North of Fence line East.

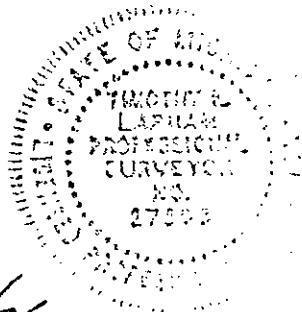

Signed by [Signature]
Surveyor's Michigan License No. 27595

Date 12/27/96