

SURVEY & REMONUMENTATION

MAY 28 1997

OGEMAW COUNTY REMONUMENTATION

LIBER 3 PAGE 76

COMMISSION

LAND CORNER RECORDATION CERTIFICATE
Filing Requirement of Act 74, Mich. P.A. 1970

For corners in

Ogemaw (County)	Located In:	Corner Code #
1. Public Land Survey	T 22N R 1E	M 9 ✓
	T 22N R 2E	A-9
	T R	
	T R	
2. Property Controlling in Section	S T R	
	S T R	
3. Miscellaneous Property in Sec.	S T R	
	S T R	

STATE OF MICHIGAN
OGEMAW COUNTY
RECORDED

30 DEC 96 4:28 P.M.

WANDA MUZIK
REGISTER OF DEEDS

Register of Deeds Stamp & File Number

4. Lot No. _____, Recorded Plat _____
5. Private Claims _____

I, Timothy L. Lapham, in a field survey on December, 19 96 do hereby state that under requirements of P.A. 74, Michigan P.A. of 1970, the corner points mentioned in lines 1 and 2 above were in conformance with regulations and rules therefore as required in the current manual of survey instructions of the United States Department of the Interior, Bureau of Land Management or by a decree of a Court of Law and/or that the corner points mentioned in lines 3, 4 and 5 above were in conformance with the rules of the Michigan Board of Land Surveyors or by a Decree of a Court of Law; established, re-established, monumented, recovered, found as expressed below:

NOTE: Not more than 2 corners, all in the same town and range, may be recorded on this certificate.

	A	B	C	D	E	F	G	H	I	J	K	L	M
1													
2	6	5	4	3	2	1							
3													
4	7	8	9	10	11	12							
5													
6	10	17	16	15	14	13							
7													
8	19	20	21	22	23	24							
9													
10	30	29	28	27	26	25							
11													
12	31	32	33	34	35	36							
13													

A. Description of original monument and accessories and/or subsequent restoration:

- | | | |
|--|--|---|
| <p>Note: Corner Common to A-9 T22N R2E
GLO L. Clason 1838
Set post
Y. Birch 12 S26W 16
Hem. 15 N56W 36
GLO B.F. Hall, 1848
Found Post
Tamarack 10 S49E 21
Cedar 10 N20E 36
LCRC Wilcox 4/88 (Rec L1, P136)
1" Iron rod, 3 Wits</p> | <p>LCRC, Lapham 4/88 (Rec L2, P8)
Found iron in mon box, 3 Wits;
LCRC, Lapham 12/8 (Rec L2, P22);
Same as L2, P8
Survey, Cavanagh, 3/72, (Rec L1, P160)
Found Pvmt bx, no wits;
Survey, Cavanagh, 10/76, (Rec L2, P219)
Fd. Pvmt bx, 3 Wits
Revised L2, P349;
Survey, Cavanagh, 9/76 (Rec L2, P222)
Same as L2, P219</p> | <p>Survey, Myers, 11/88 (Rec L4, P209)
Mon Box
References L1 P136
M-DOT ROW map, no material or Wits;
Plat, Holmes, Village of West Branch (Rec L1, P1)
No material or Wits;
Plat, Hook, 10/58, "Martin and Larocque Subdivision" (Rec L3, P8)
No material or Wits;
Plat, Henning, 8/53, "Plat of Latter's Acres" (Rec L3, P20)</p> |
|--|--|---|


B. Description of corner evidence found and/or method applied in restoring or reestablishing corner:

No evidence of GLO found. Found bent 1/2" iron rod in monument box and Power poles called for in Cavanagh surveys and Lapham LCRCs. Accepted found corner as best evidence of the position of the original corner. See dossier for additional information.

APPROVED BY
PEER REVIEW
12-18-96 TL
DATE P.A. 345 of 1990

C. Description of monument for corner and accessories established to perpetuate locating the position of the corner:

- Set 5/8" X 36" rerod with 2-1/4" Aluminum cap marked "1996 27595"
- In Monument Box
- From Which:
- N34E 44.10' Utility Pole
- S50W 59.54' Utility Pole
- S33E 50.31' Utility Pole
- N51W 124.11' SE corner of White House

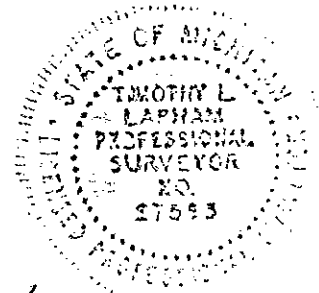

Signed by [Signature]
Surveyor's Michigan License No. 27595

Date 12/27/96