

SURVEY & REMONUMENTATION

MAY 28 1997

COMMISSION

LIBER 3 PAGE 77

OGEMAW COUNTY REMONUMENTATION

LAND CORNER RECORDATION CERTIFICATE
Filing Requirement of Act 74, Mich. P.A. 1970

For corners in

Ogemaw
(County)

Located in:

Corner Code #

1. Public Land Survey

T 22N R 1E M-10 ✓

T 22N R 2E A-10

T R

T R

2. Property Controlling in Section

S T R

S T R

3. Miscellaneous Property in Sec.

S T R

S T R

4. Lot No. _____, Recorded Plat _____

5. Private Claims _____

STATE OF MICHIGAN
OGEMAW COUNTY
RECORDED

30 DEC 96 4:29 P.M.

WANDA MUZIK
REGISTER OF DEEDS

Register of Deeds Stamp & File Number

A	B	C	D	E	F	G	H	I	J	K	L	M
1												
2	6	5	4	3	2	1						
3												
4	7	8	9	10	11	12						
5												
6	18	17	16	15	14	13						
7												
8	19	20	21	22	23	24						
9												
10	30	29	28	27	26	25						
11												
12	31	32	33	34	35	36						
13												

I, Timothy L. Lapham, in a field survey on December, 1996 do hereby state that under requirements of P.A. 74, Michigan P.A. of 1970, the corner points mentioned in lines 1 and 2 above were in conformance with regulations and rules therefore as required in the current manual of survey instructions of the United States Department of the Interior, Bureau of Land Management or by a decree of a Court of Law and /or that the corner points mentioned in lines 3, 4 and 5 above were in conformance with the rules of the Michigan Board of Land Surveyors or by a Decree of a Court of Law; established, re-established, monumented, recovered, found as expressed below.

NOTE: Not more than 2 corners, all in the same town and range, may be recorded on this certificate.

A. Description of original monument and accessories and/or subsequent restoration:

Note: Corner Common to A-10 T22N R2E
GLO L. Clason, 1838
Set post
Beech 12" S43W 31 links
do 11" N79W 39 links
Survey, Henning, 11/72, (Rec L1, P185)
PK nail in Fvmt
1/2" Iron 60 East
Survey, Caldwell, 8/73 (Rec L1, P241)
No corner material or witnesses
Survey, Caldwell, 8/73 (Rec L1, P242)

No corner material or witnesses
Survey, Higgins, 10/78 (Rec L2, P525)
PK nail of record
No witnesses
Survey, Myers, 11/88 (Rec L4, P208)
Found 1/2" bar in mon box
Ref. Mon 75.0' East
M-DOT ROW map, no material or wits;
Plat, McGinnis, "West Branch Industrial Park West"
(Rec L8, P20)
No Material or wits;


B. Description of corner evidence found and/or method applied in restoring or reestablishing corner:

No evidence of GLO found. Found 1/2" Iron on monument box in center line of M-30. Location matches Plat. Accepted as best evidence of the position of the original corner.
See dossier for additional information.

APPROVED BY
PEER REVIEW
12-18-96 TL
DATE P.A. 345 of 1990

C. Description of monument for corner and accessories established to perpetuate locating the position of the corner:

Set 5/8"X36" rerod with 2-1/4" Aluminum cap marked "1996 27595"
From Which:
S88E 60.50' Capped Iron
S33E 121.90' Top of Fire Hydrant
S18W 102.83' N. End of 12" culvert
N86W 61.38' Top of Tele Ped.

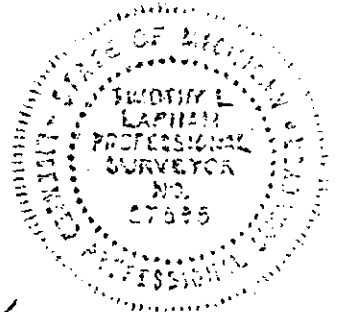

Signed by [Signature]
Surveyor's Michigan License No. 27595

Date 12/27/96