

**SURVEY & REMONUMENTATION**

MAY 28 1997

COMMISSION

OGEMAW COUNTY REMONUMENTATION

LIBER 3 PAGE 78

**LAND CORNER RECORDATION CERTIFICATE**  
Filing Requirement of Act 74, Mich. P.A. 1970

For corners in

Ogemaw  
(County)

Located in:

Corner Code #

1. Public Land Survey

T 22N R 1E	M - 11
T 22N R 2E	A - 11
T R	
T R	
S T R	
S T R	
S T R	
S T R	

2. Property Controlling in Section

3. Miscellaneous Property in Sec.

4. Lot No. \_\_\_\_\_, Recorded Plat \_\_\_\_\_

5. Private Claims \_\_\_\_\_

STATE OF MICHIGAN  
OGEMAW COUNTY  
RECORDED

30 DEC 96 4:29 P.M.

WANDA MUZIK  
REGISTER OF DEEDS

Register of Deeds Stamp & File Number

I, Timothy L. Lapham, in a field survey on December, 1996 do hereby state that under requirements of P.A. 74, Michigan P.A. of 1970, the corner points mentioned in lines 1 and 2 above were in conformance with regulations and rules therefore as required in the current manual of survey instructions of the United States Department of the Interior, Bureau of Land Management or by a decree of a Court of Law and/or that the corner points mentioned in lines 3, 4 and 5 above were in conformance with the rules of the Michigan Board of Land Surveyors or by a Decree of a Court of Law; established, re-established, monumented, recovered, found as expressed below.

NOTE: Not more than 2 corners, all in the same town and range, may be recorded on this certificate.

	A	B	C	D	E	F	G	H	I	J	K	L	M
1													
2	6		5		4		3		2		1		
3													
4	7		8		9		10		11		12		
5													
6	18		17		16		15		14		13		
7													
8	19		20		21		22		23		24		
9													
10	30		29		28		27		26		25		
11													
12	31		32		33		34		35		36		
13													

A. Description of original monument and accessories and/or subsequent restoration:

Note: Corner common to A-11 T22N R2E

GLO, L. Clason 1838

Set Post

Hem 11" S88W 11 links

do 10" N49W 22 links

GLO B.F. Hall, 1848

Found post

Hemlock 18" N48E 32 links

do 12" S13E 9 links

LCRC, Wilcox, 4/88 (Rec 2/77 L1, P142)

Found 1/2" iron rod

N60E 66.38' T. Pole

Due East 60.80' Corner Fence post

S70W 63.42' Fence post

N45W 60.49' R.R. Tie Fence post

M-DOT ROW map, No material or Wits;

B. Description of corner evidence found and/or method applied in restoring or reestablishing corner.

No evidence of GLO found. Found 3/8" iron in monument box and two Wilcox witnesses. Accepted found iron as best available evidence of the position of the original corner.

See dossier for additional information.

APPROVED BY  
PEER REVIEW  
12-18-96  
DATE P.A. 345 of 1990

C. Description of monument for corner and accessories established to perpetuate locating the position of the corner:

Set 5/8" X 3/8" rerod with 2-1/4" Aluminum cap marked "1996 27595"

In Monument Box

From Which:


S88E 65.85' Utility pole

S37E 168.23' S.W. Corner of BLD

S82W 61.40' Utility pole

N46W 82.77' R/R Tie Fence post

Monument located 1' West of centerline of M-30

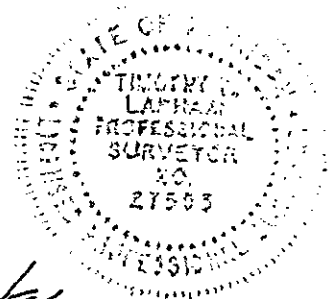

Signed by [Signature]  
Surveyor's Michigan License No. 27595

Date 12/27/96