

**SURVEY & REMONUMENTATION**

OGEMAW COUNTY REMONUMENTATION

MAY 28 1997

**LAND CORNER RECORDATION CERTIFICATE**  
Filing Requirement of Act 74, Mich. P.A. 1970

For corners in **COMMISSION**

<u>Ogemaw</u> (County)	Located In:	Corner Code #
1. Public Land Survey	T <u>22N</u> R <u>1E</u>	<u>M - 1</u>
	T <u>22N</u> R <u>1E</u>	<u>M - 13</u>
	T <u>22N</u> R <u>2E</u>	<u>A - 1</u> ✓
	T <u>22N</u> R <u>2E</u>	<u>A - 13</u>
2. Property Controlling in Section	S ___ T ___ R ___	___
	S ___ T ___ R ___	___
3. Miscellaneous Property in Sec.	S ___ T ___ R ___	___
	S ___ T ___ R ___	___

STATE OF MICHIGAN  
OGEMAW COUNTY  
RECORDED

30 DEC 96 4:27 P.M.

WANDA NUZIK  
REGISTER OF DEEDS

Register of Deeds Stamp & File Number

4. Lot No. \_\_\_\_\_, Recorded Plat \_\_\_\_\_  
5. Private Claims \_\_\_\_\_

A	B	C	D	E	F	G	H	I	J	K	L	M
1												
2	6	5	4	3	2	1						
3												
4	7	8	9	10	11	12						
5												
6	18	17	16	15	14	13						
7												
8	19	20	21	22	23	24						
9												
10	30	29	28	27	26	25						
11												
12	31	32	33	34	35	36						
13												

I, Timothy L. Lapham, in a field survey on December, 19 96 do hereby state that under requirements of P.A. 74, Michigan P.A. of 1970, the corner points mentioned in lines 1 and 2 above were in conformance with regulations and rules therefore as required in the current manual of survey instructions of the United States Department of the Interior, Bureau of Land Management or by a decree of a Court of Law and/or that the corner points mentioned in lines 3, 4 and 5 above were in conformance with the rules of the Michigan Board of Land Surveyors or by a Decree of a Court of Law, established, re-established, monumented, recovered, found as expressed below:

NOTE: Not more than 2 corners, all in the same town and range, may be recorded on this certificate.

**A. Description of original monument and accessories and/or subsequent restoration:**

Note: Corner Common to A-1 T22N R2E  
GLO Clason 1838  
Set post  
Spruce Pine 7 N27W 48 links  
Spruce Pine 7 S49E 48 links  
Survey, Richardson 8/74  
No material or Witnesses  
Survey, Cavanagh 6/79 (Rec L3, P61)  
No corner Material or Witnesses


**B. Description of corner evidence found and/or method applied in restoring or reestablishing corner:**

No evidence of GLO found. Found 2" Iron pipe at intersection of trails. Pipe lies 7' east of centerline trail south and 8' north of centerline of trail East-West. Found fence corner running West and North at 34' west. Also found three apparent witness trees, origin unknown. Accepted found pipe as the best available evidence of the position of the original corner. See dossier for additional information.

**C. Description of monument for corner and accessories established to perpetuate locating the position of the corner:**

Set 5/8" X 36" rerod with 2-1/4" Aluminum cap marked "1996 27595"  
From Which:  
N47E 29.61' 12" Oak  
S85E 15.08' 8" W. Oak  
S45W 28.09' 8" W. Oak  
N22W 17.21' 10" Twin W. Oak  
Monument located 7' East of centerline trail South and 8' North of centerline trail East-West and 34' West to Fence corner West and North.

APPROVED BY  
PEER REVIEW  
DATE 12-18-96  
P.A. 345 of 1990

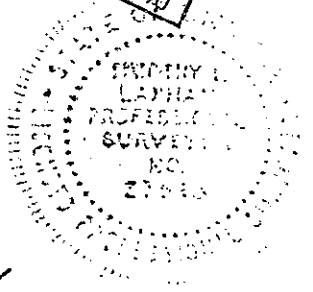

Signed by [Signature]  
Surveyor's Michigan License No. 27595

Date 12/27/96