

SURVEY & REMONUMENTATION

MAY 28 1997

OGEMAW COUNTY REMONUMENTATION

LIBER 3 PAGE 73

COMMISSION

LAND CORNER RECORDATION CERTIFICATE
Filing Requirement of Act 74, Mich. P.A. 1970

For corners in

Ogemaw (County)	Located In:	Corner Code #
1. Public Land Survey	T 22N R 1E	M - 6
	T 22N R 2E	A - 6
	T R	
	T R	
2. Property Controlling in Section	S T R	
	S T R	
3. Miscellaneous Property in Sec.	S T R	
	S T R	

STATE OF MICHIGAN
OGEMAW COUNTY
RECORDED
30 DEC 96 4:28 P.M.
WANDA MUZIK
REGISTER OF DEEDS

Register of Deeds Stamp & File Number

4. Lot No. _____, Recorded Plat _____
5. Private Claims _____

I, Timothy L. Lapham, in a field survey on December, 19 96 do hereby state that under requirements of P.A. 74, Michigan P.A. of 1970, the corner points mentioned in lines 1 and 2 above were in conformance with regulations and rules therefore as required in the current manual of survey instructions of the United States Department of the Interior, Bureau of Land Management or by a decree of a Court of Law and for that the corner points mentioned in lines 3, 4 and 5 above were in conformance with the rules of the Michigan Board of Land Surveyors or by a Decree of a Court of Law; established, re-established, monumented, recovered, found as expressed below:

NOTE: Not more than 2 corners, all in the same town and range, may be recorded on this certificate.

	A	B	C	D	E	F	G	H	I	J	K	L	M
1													
2	6		5		4		3		2		1		
3													
4	7		8		9		10		11		12		
5													
6	18		17		16		15		14		13		
7													
8	19		20		21		22		23		24		
9													
10	30		29		28		27		26		25		
11													
12	31		32		33		34		35		36		
13													

A. Description of original monument and accessories and/or subsequent restoration:

Note: Corner Common to A-6 T22N R2E
GLO L. Clason 1838
Set post
Hem. 8 S16W 28 links
Y. Birch 12 N37W 36 links
Survey Higgins, 8/76 (Rec L2, P150)
Found 3/4" draw pin, replaced with 1/2" X18" steel bar
3 wits;
LCRC, Higgins, 11/76 (Rec L1, P78)
Same as survey L2, P150

LCRC, Act 313, 9/77 (Rec L1, P182)
Same as survey L2, P150;
LCRC, Lapham, 10/85 (Rec L1, P327)
1/2" RLS capped rerod, 4 wits;
Survey, Lapham 7/93 (Rec L5, P350-355)
1/2" iron, 4 witnesses;


B. Description of corner evidence found and/or method applied in restoring or reestablishing corner:

No evidence of GLO corner found, Creek South measures close to GLO. Found 1/2" capped iron (number illegable). Found two Lapham and one Higgins witnesses. Distance South to M-7 in accord with Higgins Survey L2, P150 and Lapham survey L5, P350. Excess distance to South indicates the possibility that a tally was dropped during GLO survey. Accepted found iron as best evidence of the position of the original corner. See dossier for additional information.

APPROVED BY
PEER REVIEW
12-18-96 *TL*
DATE P.A. 345 of 1990

C. Description of monument for corner and accessories established to perpetuate locating the position of the corner:

Set 5/8" X36" rerod with 2-1/4" Aluminum cap marked "1996 27595"
From Which:
S68E 43.20' 14" S. Pine
S41E 68.51' 12" S. Pine
S38W 52.16' 6" Cedar
S71W 38.88' 12" Poplar
Monument located 4' West of centerline of Dow Road North-South

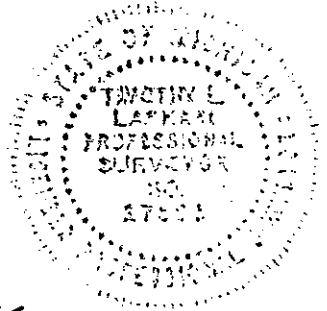

Signed by *Timothy L. Lapham*
Surveyor's Michigan License No. 27595

Date 12/27/96