

LAND CORNER RECORDATION CERTIFICATE  
Filing Requirement of Act 74, Mich. P.A. 1970

For corners in

Ogemaw (County) Located In: Corner Code #

- 1. Public Land Survey  
T 22N R 1E  
~~T 22N R 2E~~ N 7  
T R  
T R
- 2. Property Controlling in Section  
S T R
- 3. Miscellaneous Property in Sec.  
S T R  
S T R

STATE OF MICHIGAN  
OGEAW COUNTY  
RECORDED  
30 DEC 96 4:28 P.M.  
WANDA MUZIK  
REGISTER OF DEEDS  
Register of Deeds Stamp & File Number

4. Lot No. \_\_\_\_\_ Recorded Plat \_\_\_\_\_  
5. Private Claims \_\_\_\_\_

I, Timothy L. Lapham, in a field survey on December, 19 96 do hereby state that under requirements of P.A. 74, Michigan P.A. of 1970, the corner points mentioned in lines 1 and 2 above were in conformance with regulations and rules therefore as required in the current manual of survey instructions of the United States Department of the Interior, Bureau of Land Management or by a decree of a Court of Law and /or that the corner points mentioned in lines 3, 4 and 5 above were in conformance with the rules of the Michigan Board of Land Surveyors or by a Decree of a Court of Law; established, re-established, monumented, recovered, found as expressed below:

NOTE: Not more than 2 corners, all in the same town and range, may be recorded on this certificate.

1	A	B	C	D	E	F	G	H	I	J	K	L	M
2		6		5		4		3		2		1	
3													
4		7		8		9		10		11		12	
5													
6		18		17		16		15		14		13	
7													
8		19		20		21		22		23		24	
9													
10		30		29		28		27		26		25	
11													
12		31		32		33		34		35		36	
13													

A. Description of original monument and accessories and/or subsequent restoration:

- Note: Corner Common to A-7 T22N R2E
- GLO L. Clason 1838  
Set post  
Cedar 8 S61E 23 links  
Tamarack 5" N08E 18 links  
GLO B.F. Hall 1846  
Found post, no wits  
Survey Cavanagh, 11/71 (Rec L1, P35)  
Found 7/8" Bar, 3 wits;  
Survey, Higgins, 8/76 (Rec L2, P108)  
Found 7/8" bar of record, no wits;
- Survey, Higgins, 8/76 (Rec L2, P150)  
Same as L2, P109
- LCRC, Higgins, 11/76 (Rec L1, P78)  
Found 7/8" bar of record, no wits;
- Survey, Higgins, 4/77 (Rec L2, P252)  
Same as L2, P109
- LCRC, Act 313, 9/77 (Rec L1, P182)  
Found 7/8" bar of record
- Survey Higgins, 9/78 (Rec L2, P531)  
1/2" bar, 2 wits;
- Survey, Ledy, 11/83 (Rec L3, P454)
- 1/2" bar, 2 wits;  
LCRC, Lapham, 10/85 (Rec L1, P327)  
Iron bar, 4 wits;  
Survey, Lapham, 7/93 (Rec L5, P350-355)  
Same as LCRC L1, P327


B. Description of corner evidence found and/or method applied in restoring or reestablishing corner:

No evidence of GLO corner found. Found 1/2" iron rod and three Lapham and one Cavanagh witnesses. Distance South to M-8 in accord with recorded surveys. Distance South to GLO topo Creek and Brook calls match GLO proportionate distance. Excess distance to North indicates the possibility that a tally was dropped during GLO survey. Accepted found corner as best evidence of the position of the original corner. See dossier for additional information.

APPROVED BY  
PEER REVIEW  
12-18-96  
DATE P.A. 345 of 1990

C. Description of monument for corner and accessories established to perpetuate locating the position of the corner:

- Set 5/8" X 3/8" rerod with 2-1/4" Aluminum cap marked "1898 27585"
- In Monument Box
- From Which:
- N25E 108.42' Utility Pole
- N84E 33.08' Capped Iron #21570
- S58E 81.82' 4" Poplar
- S22W 133.48' 8" Scotch Pine
- Monument located 1.5' East of centerline Dow Road North-South and 20' North of Fence line East.

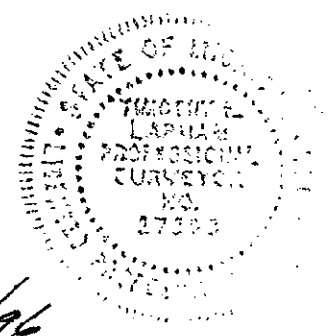

Signed by [Signature]  
Surveyor's Michigan License No. 27585

Date 12/27/96