

SURVEY & REMONUMENTATION

MAY 28 1997

OGEMAW COUNTY REMONUMENTATION

LIBER 3 PAGE 78

LAND CORNER RECORDATION CERTIFICATE
Filing Requirement of Act 74, Mich. P.A. 1970

For corners in **COMMISSION**

<u>Ogemaw</u> (County)	Located in:	Corner Code #
1. Public Land Survey	T 22N R 1E	M - 11
	T 22N R 2E	<u>A - 11</u>
	T ___ R ___	_____
	T ___ R ___	_____
2. Property Controlling in Section	S ___ T ___ R ___	_____
	S ___ T ___ R ___	_____
3. Miscellaneous Property in Sec.	S ___ T ___ R ___	_____
	S ___ T ___ R ___	_____

STATE OF MICHIGAN
OGEMAW COUNTY
RECORDED
30 DEC 96 4:29 P.M.
WANDA MUZIK
REGISTER OF DEEDS
Register of Deeds Stamp & File Number

4. Lot No. _____, Recorded Plat _____
5. Private Claims _____

A	B	C	D	E	F	G	H	I	J	K	L	M
1												
2	6	5	4	3	2	1						
3												
4	7	8	9	10	11	12						
5												
6	18	17	16	15	14	13						
7												
8	19	20	21	22	23	24						
9												
10	30	29	28	27	26	25						
11												
12	31	32	33	34	35	36						
13												

I, Timothy L. Lapham, in a field survey on December, 19 96 do hereby state that under requirements of P.A. 74, Michigan P.A. of 1970, the corner points mentioned in lines 1 and 2 above were in conformance with regulations and rules therefore as required in the current manual of survey instructions of the United States Department of the Interior, Bureau of Land Management or by a decree of a Court of Law and /or that the corner points mentioned in lines 3, 4 and 5 above were in conformance with the rules of the Michigan Board of Land Surveyors or by a Decree of a Court of Law; established, re-established, monumented, recovered, found as expressed below:

NOTE: Not more than 2 corners, all in the same town and range, may be recorded on this certificate.

A. Description of original monument and accessories and/or subsequent restoration:

Note: Corner common to A-11 T22N R2E
 GLO, L. Clason 1838
 Set Post
 Hem 11" S68W 11 links
 do 10" N49W 22 links
 GLO B.F. Hall, 1846
 Found post
 Hemlock 18" N46E 32 links
 do 12" S13E 9 links
 LCRC, Wilcox, 4/66 (Rec 2/77 L1, P142)
 Found 1/2" Iron rod
 N60E 66.38' T.Pole
 Dus East 60.80' Corner Fence post
 S70W 63.42' Fence post
 N45W 80.49' R.R. Tie Fence post
 M-DOT ROW map, No material or Wfts;


B. Description of corner evidence found and/or method applied in restoring or reestablishing corner:

No evidence of GLO found. Found 3/8" iron in monument box and two Wilcox witnesses. Accepted found iron as best available evidence of the position of the original corner. See dossier for additional information.

APPROVED BY
PEER REVIEW
12-18-96 TL
DATE P.A. 345 of 1990

C. Description of monument for corner and accessories established to perpetuate locating the position of the corner:

Set 5/8" X 36" rerod with 2-1/4" Aluminum cap marked "1886 27595"
 In Monument Box
 From Which:
 S66E 65.85' Utility pole
 S37E 166.23' S.W. Corner of BLD
 S82W 61.40' Utility pole
 N46W 82.77' R/R Tie Fence post
 Monument located 1' West of centerline of M-30

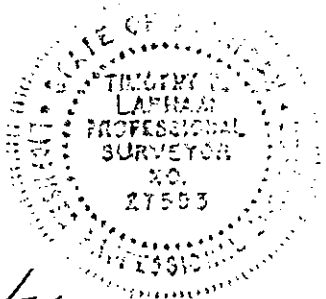

Signed by [Signature]
Surveyor's Michigan License No. 27595

Date 12/22/96