

**SURVEY & REMONUMENTATION**

MAY 28 1987

COMMISSION

OGEMAW COUNTY REMONUMENTATION

LIBER 3 PAGE 79

**LAND CORNER RECORDATION CERTIFICATE**  
Filing Requirement of Act 74, Mich. P.A. 1970

For corners in

<u>Ogemaw</u> (County)	Located in:	Corner Code #
1. Public Land Survey	T 22N R 1E	M - 12
	T 22N R 2E	A - 12
	T R	
	T R	
2. Property Controlling In Section	S T R	
	S T R	
3. Miscellaneous Property in Sec.	S T R	
	S T R	
4. Lot No. _____, Recorded Plat _____		
5. Private Claims _____		

STATE OF MICHIGAN  
OGEMAW COUNTY  
RECORDED  
30 DEC 96 4:29 P.M.  
WANDA MUZIK  
REGISTER OF DEEDS  
Register of Deeds Stamp & File Number

A	B	C	D	E	F	G	H	I	J	K	L	M
1												
2	6		5		4		3		2		1	
3												
4	7		8		9		10		11		12	
5												
6	18		17		16		15		14		13	
7												
8	19		20		21		22		23		24	
9												
10	30		29		28		27		26		25	
11												
12	31		32		33		34		35		36	
13												

I, Timothy L. Lapham, in a field survey on December, 19 96 do hereby state that under requirements of P.A. 74, Michigan P.A. of 1970, the corner points mentioned in lines 1 and 2 above were in conformance with regulations and rules therefore as required in the current manual of survey instructions of the United States Department of the Interior, Bureau of Land Management or by a decree of a Court of Law and for that the corner points mentioned in lines 3, 4 and 5 above were in conformance with the rules of the Michigan Board of Land Surveyors or by a Decree of a Court of Law; established, re-established, monumented, recovered, found as expressed below:

NOTE: Not more than 2 corners, all in the same town and range, may be recorded on this certificate.

A. Description of original monument and accessories and/or subsequent restoration:

Note: Corner Common to A-12 T22N R2E

GLO, L. Clason, 1838	No corner material or witnesses
Beech 10" S43W 13 links	LCRC Higgins 2/15/82 (Rec L1, P257)
Red Oak 18" N35W 33 links	1/2" Steel bar
LCRC Wilcox, 4/66 (rec 2/77 L1, P143)	N45E 49.59' 28" Twin Basswood
1/2" Bar	S80E 41.33' 30" Twin Ash
N45E 49.59' 28" Basswood	S30E 89.42' 23" Elm
S80E 41.33' 30" Twin Ash	S60W 38.17' Power Pole
S30E 89.42' 23" Elm	MDOT ROW map, no material or wits;
S60W 38.17' P.Pole	Survey, Henning Section Subdivision
Survey, Higgins, 9/30/80 (Rec L3, P178, L3, P196)	No material or witnesses


B. Description of corner evidence found and/or method applied in restoring or reestablishing corner:

No evidence of GLO found. Corner apparently torn out during road construction. Set monument at GLO proportionate & M-DOT proportionate distance on Township line. See dossier for additional information.

APPROVED BY  
PEER REVIEW  
12-18-96 JLL  
DATE P.A. 345 of 1990

C. Description of monument for corner and accessories established to perpetuate locating the position of the corner:

Set 5/8" X 3/8" rod with 2-1/4" Aluminum cap marked "1996 27595"  
From Which:  
N42E 122.87' Utility Pole  
N85E 107.24' 4" Ash  
S18E 29.77' Guard rail post  
N82W 27.29' Guard rail post  
Monument located in median of I-75, 50' North of centerline of Southbound lanes.

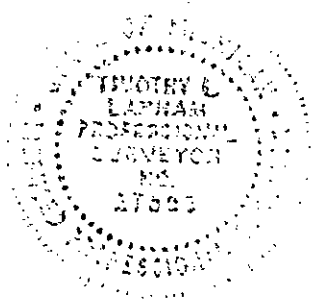

Signed by [Signature]  
Surveyor's Michigan License No. 27595

Date 12/27/96